

Newton
L48
70

MISSISSIPPI
BOARD OF WATER COMMISSIONERS
416 North State Street
Jackson, Mississippi 39201

CODED

WATER WELL DRILLERS LOG

19 70 McDonald Hill Inc Newton
date well completed firm name county well located

LANDOWNER: <u>Billie NOVEMAN</u>	description of formations encountered	from	to
<u>RT-1</u>	<u>Clay</u>	<u>0</u>	<u>20</u>
<u>Newton, Miss</u> (mailing address)	<u>fine sand</u>	<u>20</u>	<u>90</u>
	<u>coarse sand</u>	<u>90</u>	<u>112</u>
WELL LOCATION:			
sec. <u>9</u> T. <u>6N</u> R. <u>12E</u>			
4 miles <u>with</u> of <u>hickory</u> (distance) (direction) (nearest town)			
WELL PURPOSE: <u>None</u> (home, irrigation, municipal, industrial)			
WELL COMPLETION DATA:			
(1) diameter (inches) <u>2</u>			
(2) total depth (feet) <u>112</u>			
(3) static water level (feet) <u>35</u> below above top of ground.			
(4) casing <u>2" Aluminum</u> <u>107</u> (material) (depth)			
<u>110</u> (size) if telescope see back.			
(5) screen <u>5</u> <u>107</u> (length) (depth to top)			
<u>2"</u> <u>plastic</u> (size) (material)			
(6) pump <u>1/2</u> <u>10</u> (HP) (yield gpm)			
<u>jet</u> (type/power)			
(7) electric log <u>no</u> (yes or no)			
<u>no</u> (organization running log)			
(8) how well bottom plugged <u>back</u> <u>pressure data</u>			
DRILLERS REMARKS: <u>none</u>			


CODED

III 15 1970

MISS. Bd. of
Water Comm.

If well telescopes please sketch and show depths.

GROUND LEVEL

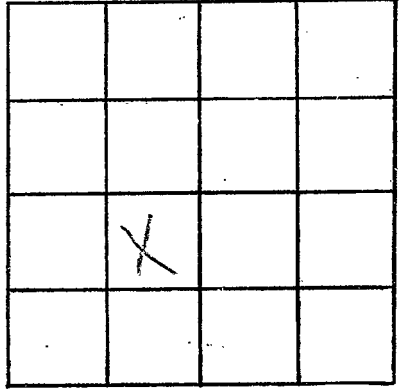

SECTION 9

Please indicate well location X.

ADDITIONAL INFORMATION

If more than one screen, show locations of each on sketch.