

NEWTON
L49
10-5-70

MISSISSIPPI
BOARD OF WATER COMMISSIONERS
416 North State Street
Jackson, Mississippi 39201

CODED

WATER WELL DRILLERS LOG

10-5-70 date well completed McDONALD + HILL firm name NEWTON county well located

LANDOWNER:
Edward STREBECK
Hickory
(mailing address)

WELL LOCATION:
sec 23 T 6 N R 12 E
3 miles N of Hickory
(distance) (direction) (nearest town)

WELL PURPOSE: HOME
(home, irrigation, municipal, industrial)

- WELL COMPLETION DATA:
- (1) diameter (inches) 4"
 - (2) total depth (feet) 278
 - (3) static water level (feet) 521 below top of ground. ~~above~~
 - (4) casing BLK 147'
(material) (depth)
4"
(size) if telescope see back.
 - (5) screen _____
(length) (depth to top)
(size) (material)
 - (6) pump 5 10
(HP) (yield gpm)
ELECTRIC
(type power)
 - (7) electric log _____
(yes or no)
(organization running log)
 - (8) how well bottom plugged OPEN

description of formations encountered	from	to
<u>Clay</u>	<u>0</u>	<u>18</u>
<u>Sand</u>	<u>18</u>	<u>70</u>
<u>Soft shale</u>	<u>70</u>	<u>105</u>
<u>shale</u>	<u>105</u>	<u>130</u>
<u>Sand</u>	<u>130</u>	<u>147</u>
<u>shale</u>	<u>147</u>	<u>268</u>
<u>Sand</u>	<u>268</u>	<u>278</u>

CODED


OCT 8 1970

MISS. BD. OF
WATER CO.

DRILLERS REMARKS:

If well telescopes please
sketch and show depths.

GROUND LEVEL

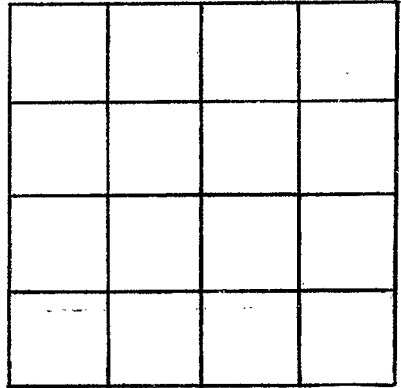

SECTION _____

Please indicate well location X.

ADDITIONAL INFORMATION

If more than one screen,
show locations of each on sketch.