

Newton  
 L50  
 2-13-70

MISSISSIPPI  
 BOARD OF WATER COMMISSIONERS  
 416 North State Street  
 Jackson, Mississippi 39201

**CODED OK**


RTN 4/17/70 JCN  
 2nd ST 1/70

WATER WELL DRILLERS LOG

2/13/70 date well completed  
 Jerry Drilling Co firm name  
 NEWTON county well located

LANDOWNER:  
 NEWTON County RECREATION ASSOC.  
 NEWTON, Mississippi  
 (mailing address)

description of formations encountered	from	to
yellow clay	0	18
Bank	18	80
blue clay	80	110
Very coarse sand	110	140
Sandy & shale	140	200
sandy	200	260
blue clay	260	375
sandy	375	400
Coarse sand	400	465

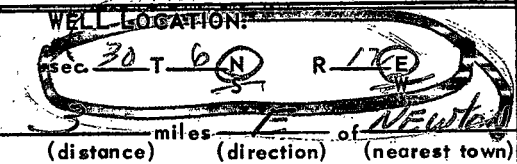

WELL PURPOSE: Club House  
 (home, irrigation, municipal, industrial)

WELL COMPLETION DATA:

- (1) diameter (inches) 4"
- (2) total depth (feet) 465"
- (3) static water level (feet) 60 below top of ground.
- (4) casing BLK, 320  
 (material) (depth)  
2" if telescope see back.  
 (size)
- (5) screen 30', 435'  
 (length) (depth to top)  
2", Stainless Steel  
 (size) (material)
- (6) pump 1 1/2, 20  
 (HP) (yield gpm)  
Submerge  
 (type power)
- (7) electric log No  
 (yes or no)  
 (organization running log)
- (8) how well bottom plugged Wash  
Value

**CODED**

~~Location  
 Needed~~

APR - 3 1970

MISS. Bd. of WATER COM.

DRILLERS REMARKS:  
 60' coarse sand in bottom of well.

