

NEWTON
L 51
8-24-70

MISSISSIPPI
 BOARD OF WATER COMMISSIONERS
 416 North State Street
 Jackson, Mississippi 39201

CODED

WATER WELL DRILLERS LOG

8-24-1970 Williams Drilling Co. Newton
 date well completed firm name county well located

LANDOWNER Clarence Russell
Hickory, Miss.
 (mailing address)

description of formations encountered	from	to
<u>top soil</u>	<u>0</u>	<u>3</u>
<u>red clay</u>	<u>3</u>	<u>12</u>
<u>sand</u>	<u>14</u>	<u>55</u>
<u>blue clay</u>	<u>55</u>	<u>115</u>
<u>rocky clay</u>	<u>115</u>	<u>310</u>
<u>sand</u>	<u>310</u>	<u>350</u>

WELL LOCATION:
 sec 25 T 6 (N) R 12 (E)
1 miles North of Hickory
 (distance) (direction) (nearest town)

WELL PURPOSE Home
 (home, irrigation, municipal, industrial)

- WELL COMPLETION DATA:
- (1) diameter (inches) 4
 - (2) total depth (feet) 350
 - (3) static water level (feet) 40 ^{below} _{above} top of ground.
 - (4) casing Black metal (material) 109 (depth)
4 (size) if telescope see back.
 - (5) screen no (length) (depth to top)
 (size) (material)
 - (6) pump 1/2 (HP) 10 (yield gpm)
Electric (type power)
 - (7) electric log no (yes or no)
no (organization running log)
 - (8) how well bottom plugged open

CODED


OCT 14 1970

DRILLERS REMARKS:

MISS. BD. OF
 WATER COMMISSIONERS

If well telescopes please
sketch and show depths.

GROUND LEVEL

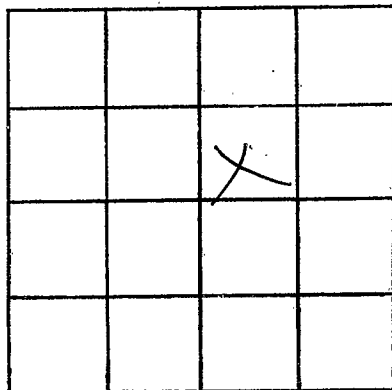

SECTION 25

Please indicate well location X.

ADDITIONAL INFORMATION

If more than one screen,
show locations of each on sketch.