

NEWTON
L52
11-24-70

MISSISSIPPI
 BOARD OF WATER COMMISSIONERS
 416 North State Street
 Jackson, Mississippi 39201

CODED

WATER WELL DRILLERS LOG

11-24- 1970 Williamson Drilling Co Newton
 date well completed firm name county well located

LANDOWNER: <u>Pickie Coleman</u> <u>Hickory, Miss</u> (mailing address)	description of formations encountered	from	to
	<u>top soil</u>	<u>0</u>	<u>3</u>
	<u>red clay</u>	<u>3</u>	<u>7</u>
	<u>blue clay</u>	<u>5</u>	<u>55</u>
	<u>sand</u>	<u>55</u>	<u>84</u>
	<u>hard rock + clay</u>	<u>84</u>	<u>245</u>
	<u>soil</u>	<u>245</u>	<u>262</u>
WELL LOCATION: sec. <u>13</u> T. <u>6N</u> R. <u>12E</u> <u>2</u> miles <u>North</u> of <u>Hickory</u> (distance) (direction) (nearest town)			
WELL PURPOSE: <u>Home</u> (home, irrigation, municipal, industrial)			
WELL COMPLETION DATA: (1) diameter (inches) <u>1 1/2</u> (2) total depth (feet) <u>262</u> (3) static water level (feet) <u>143</u> <u>below</u> top of ground. (4) casing <u>Blackmetal 95</u> (material) (depth) <u>4</u> if telescope see back. (size) (5) screen <u>no</u> (length) (depth to top) (size) (material) (6) pump <u>1/2</u> <u>11</u> (HP) (yield gpm) <u>Elect.</u> (type power) (7) electric log <u>no</u> (yes or no) <u>no</u> (organization running log) (8) how well bottom plugged <u>Open</u>			
DRILLERS REMARKS:			


CODED

DEC 28 1970

MISS. Bd. OF
 WATER COMM.

If well telescopes please sketch and show depths.

GROUND LEVEL

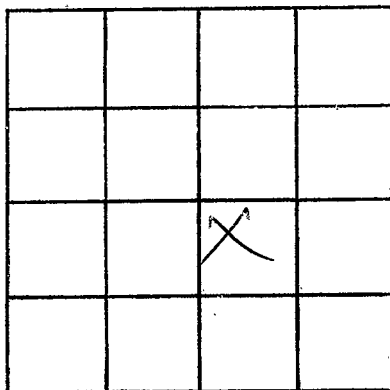

SECTION 13

Please indicate well location X.

ADDITIONAL INFORMATION

If more than one screen,
show locations of each on sketch.