

NEWTON
L 54
6-7-65

newton

WATER WELL DRILLERS LOG **CODED**

Date: 6-7, 1965, Dr. Donald Hill, Inc. County Lauderdale
(Name)

(1) Owner of Land: Walter Riley
(Name)
Rt # Hickory, Miss
(Address)

(2) Location: 1/4, 1/4, Sec. 25 6N 12E
T R

1/2 miles NW of Hickory
(distance) (direction) (Nearest Town)

(3) Topography: Domestic
(Hilly) (Flat) (Level)

(4) Purpose of Well: Domestic
(Domestic Irrigation
Municipal, Industrial, Other)

| Description & Color of Materials Sand, Clay, Red Clay, Shell, etc. | Thick- ness Feet | Depth Feet. |
|---|------------------------|----------------|
| clay & sand | 0 | 18 |
| shale | 18 | 65 |
| H shale fine rock | 65 | 95 |
| sandy shale | 95 | 109 |
| lime rock shale str. | 109 | 122 |
| H shale | 122 | 130 |
| lime rock shale | 130 | 152 |
| H shale | 152 | 159 |
| H shale lime rock | 159 | 200 |
| shale | 200 | 220 |
| sandy shale | 220 | 230 |
| C Sand | 230 | 242 |
| A fine sand | 242 | 250 |

Information upon completion of well:

(1) Diameter 4 inches.

(2) Total Depth 250 feet.

(3) Water Level 42 feet below top of ground.

(4) Cased to 154, Size 4 1/2

(5) Screen: Size _____, Length _____


(6) Were the formations sealed against pollution?
yes, no.

If YES depth of formation _____

Why _____

Drillers Remarks: _____

CODED
JUN 10 1965

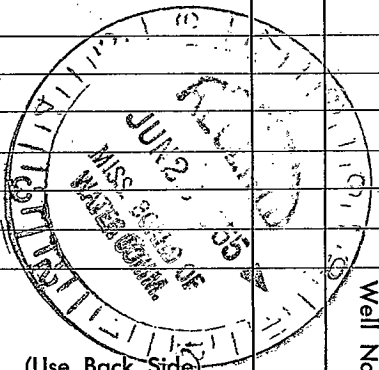

(Use Back Side)

Well No.

1000