

NEWTON
L 55
3-30-71

MISSISSIPPI
 BOARD OF WATER COMMISSIONERS
 416 North State Street
 Jackson, Mississippi 39201

CODED

WATER WELL DRILLERS LOG

3-30- date well completed 1971 Williams Drilling Co., Newton firm name Newton county well located

LANDOWNER: Wilkie Gensell
Box 210
Hickory, Miss.
 (mailing address)

description of formations encountered	from	to
<u>top soil</u>	<u>0</u>	<u>2</u>
<u>blue clay</u>	<u>2</u>	<u>25</u>
<u>sand</u>	<u>25</u>	<u>41</u>
<u>blue clay</u>	<u>41</u>	<u>75</u>
<u>sand</u>	<u>75</u>	<u>120</u>
<u>clay & rock</u>	<u>120</u>	<u>330</u>
<u>sand</u>	<u>330</u>	<u>365</u>

WELL LOCATION:
 sec 26 T 6 N R 12 E
1 miles North of Hickory
 (distance) (direction) (nearest town)

WELL PURPOSE: Home
 (home, irrigation, municipal, industrial)

- WELL COMPLETION DATA:
- (1) diameter (inches) 4
 - (2) total depth (feet) 365
 - (3) static water level (feet) 59 below top of ground
 - (4) casing Black metal 129
 (material) (depth)
 - 4 if telescope see back.
 (size)
 - (5) screen no
 (length) (depth to top)
 - (size) (material)
 - (6) pump 1/2 5
 (HP) (yield gpm)
 - Elect.
 (type power)
 - (7) electric log no
 (yes or no)
 - no
 (organization running log)
 - (8) how well bottom plugged open

CODED


JUN 10 1971

MISS. BD. OF
WATER COMM.

DRILLERS REMARKS:

If well telescopes please sketch and show depths.

GROUND LEVEL

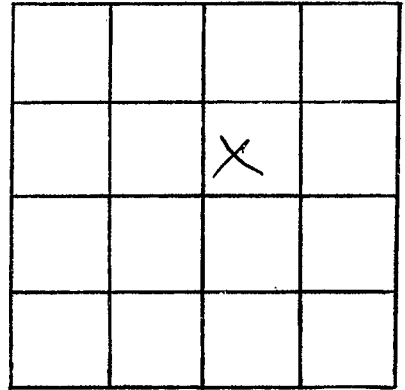

SECTION 26

Please indicate well location X.

ADDITIONAL INFORMATION

If more than one screen,
show locations of each on sketch.