

Newton
L-56
6-18-71

MISSISSIPPI
BOARD OF WATER COMMISSIONERS
416 North State Street
Jackson, Mississippi 39201

CODED

WATER WELL DRILLERS LOG

6-18-1971 date well completed
Williamson Drilling Co. firm name
Newton county well located

LANDOWNER: J. M. Hobson	description of formations encountered	from	to
Pl 1	top soil	0	3
Hickory (mailing address)	Blue Clay	3	35
	soil	35	138
	Blue Clay	138	160
	rocky Clay	160	320
	soil	320	367
WELL LOCATION:			
sec 35 T 6 N R 12 E			
1/2 miles West of Hickory (distance) (direction) (nearest town)			
WELL PURPOSE: Home (home, irrigation, municipal, industrial)			
WELL COMPLETION DATA:			
(1) diameter (inches) 4			
(2) total depth (feet) 367			
(3) static water level (feet) 70 below top of ground			
(4) casing black metal (material) 144 (depth)			
4 (size) If telescope see back.			
(5) screen no (length)			
(size) (material)			
(6) pump 1/2 (HP) 12 (yield gpm)			
Elect. (type power)			
(7) electric log no (yes or no)			
no (organization running log)			
(8) how well bottom plugged open			
DRILLERS REMARKS:			


CODED

SEP 8 1971

MISS. BD. OF
WATER COM.:

If well telescopes please sketch and show depths.

GROUND LEVEL

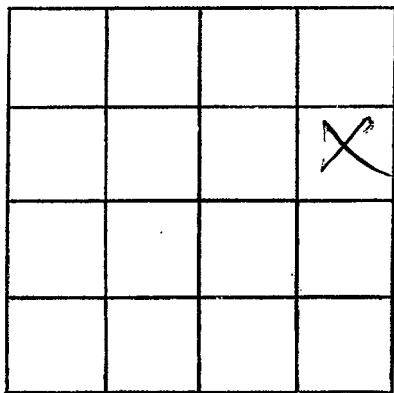

SECTION 35

Please indicate well location X.

ADDITIONAL INFORMATION

If more than one screen, show locations of each on sketch.