

Newton
L 59
6-22-72

MISSISSIPPI
 BOARD OF WATER COMMISSIONERS
 416 North State Street
 Jackson, Mississippi 39201

CODED

WATER WELL DRILLERS LOG

6-22 1972 W. J. L. Shelch Newton
 date well completed firm name county well located

LANDOWNER:
R. Anderson
Hiboy Miss
 (mailing address)

description of formations encountered	from	to
<u>Red clay</u>	<u>0</u>	<u>16</u>
<u>Gravel</u>	<u>16</u>	<u>74</u>
<u>Sand</u>	<u>74</u>	<u>110</u>

WELL LOCATION:
 sec 21 T 6 N R 12 E
2 miles N.E. of Hiboy
 (distance) (direction) (nearest town)

WELL PURPOSE: Domestic
 (home, irrigation, municipal, industrial)

- WELL COMPLETION DATA:
- (1) diameter (inches) 2"
 - (2) total depth (feet) 110
 - (3) static water level (feet) 28 below above top of ground.
 - (4) casing Gal Steel
 (material) (depth)
 (size) If telescope see back.
 - (5) screen 5
 (length) (depth to top)
2 1/4" 5 Steel
 (size) (material)
 - (6) pump 1/2 500
 (HP) (yield gpm)
elec
 (type power)
 - (7) electric log (yes or no) _____
 (organization running log) _____
 - (8) how well bottom plugged _____

CODED


JUN 26 1972

DRILLERS REMARKS:

REC'D BY
 WAYER ROOM

If well telescopes please sketch and show depths.

GROUND LEVEL

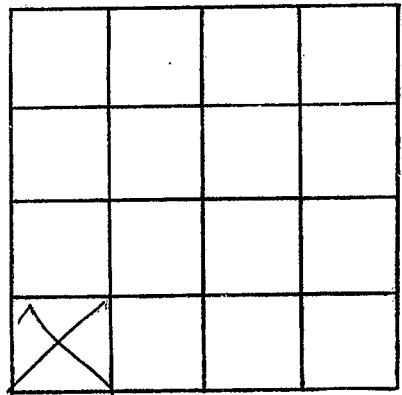

SECTION _____

Please indicate well location X.

ADDITIONAL INFORMATION

If more than one screen, show locations of each on sketch.