

Newton
L 62
9-16-72

MISSISSIPPI
 BOARD OF WATER COMMISSIONERS
 416 North State Street
 Jackson, Mississippi 39201

CODED

WATER WELL DRILLERS LOG

9-16 1972 W. L. Shelch Newton
 date well completed firm name county well located

LANDOWNER: N. Lemon
Newton Miss

description of formations encountered	from	to
<u>Brown Clay</u>	<u>0</u>	<u>40</u>
<u>Brown + Gray</u>	<u>510</u>	<u>84</u>
<u>Gravel</u>	<u>80</u>	<u>120</u>
<u>Sand</u>	<u>120</u>	<u>160</u>

(mailing address)

WELL LOCATION:
 sec. 20 T. 6 (N) R. 12 (E)
1/2 miles E of Newton
 (distance) (direction) (nearest town)

WELL PURPOSE: Home
 (home, irrigation, municipal, industrial)

WELL COMPLETION DATA:

- (1) diameter (inches) 3"
- (2) total depth (feet) 160
- (3) static water level (feet) 45 below above top of ground.
- (4) casing Gal Steel (material) (depth) _____
 (size) If telescope see back.
- (5) screen 10 (length) (depth to top) _____
3" (size) Plastic (material)
- (6) pump 1/2 (HP) 300 (yield gpm)
 (type power) _____
- (7) electric log no (yes or no)
 (organization running log) _____
- (8) how well bottom plugged _____

CODED


SEP 21 1972

DRILLERS REMARKS:

MISS. BOARD OF WATER COMMISSIONERS

If well telescopes please sketch and show depths.

GROUND LEVEL

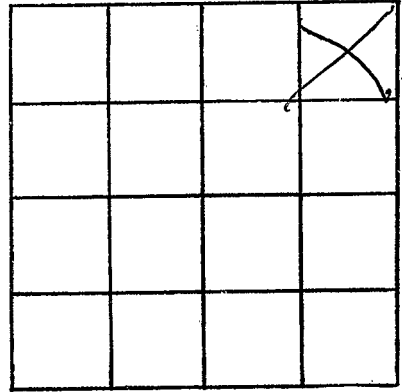

SECTION _____

Please indicate well location X.

ADDITIONAL INFORMATION

If more than one screen, show locations of each on sketch.