

Newton
L63
9-8-72

MISSISSIPPI
 BOARD OF WATER COMMISSIONERS
 416 North State Street
 Jackson, Mississippi 39201

CODED

WATER WELL DRILLERS LOG

9-8 1972 S. L. Welch Newton
 date well completed firm name county well located

LANDOWNER: Ray Wilson
Newton, Miss.
 (mailing address)

description of formations encountered	from	to
<u>red clay</u>	<u>0</u>	<u>29</u>
<u>& sandy</u>	<u>20</u>	<u>50</u>
<u>blacked</u>	<u>30</u>	<u>115</u>
<u>blue</u>	<u>30</u>	<u>115</u>
<u>sand</u>	<u>115</u>	<u>155</u>

WELL LOCATION:
 sec. 20 T. 4 N. R. 12 E
4 miles E of Newton
 (distance) (direction) (nearest town)

WELL PURPOSE: home
 (home, irrigation, municipal, industrial)

WELL COMPLETION DATA:

(1) diameter (inches) 2"

(2) total depth (feet) 155

(3) static water level (feet) 43 below top of ground.

(4) casing (material) Gal Steel (depth) _____

_____ if telescope see back.

(5) screen (length) 6' (depth to top) _____

2 3/8" (size) Gal Steel (material)

(6) pump (HP) 1 (yield gpm) 400

(type power) _____

(7) electric log no (yes or no)

(organization running log) _____

CODED

(8) how well bottom plugged _____


DRILLERS REMARKS: _____

SEP 27 1972

MISS. DEP. OF AGRICULTURE
 MISS. BOARD OF WATER COMMISSIONERS

If well telescopes please sketch and show depths.

GROUND LEVEL

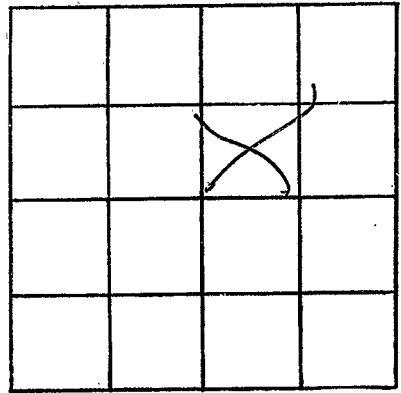

SECTION _____

Please indicate well location X.

ADDITIONAL INFORMATION

If more than one screen, show locations of each on sketch.