

Newton
L66
1-29-73

MISSISSIPPI
 BOARD OF WATER COMMISSIONERS
 416 North State Street
 Jackson, Mississippi 39201

WATER WELL DRILLERS LOG

CODED

1.29.73
 date well completed

McDonald Hill
 firm name

NEWTON
 county well located

LANDOWNER:

LEE BUFKIN

R#1 DECATUR
 (mailing address)

WELL LOCATION:

sec. 15 T. 60 R. 120
3 miles North of Hickory
 (distance) (direction) (nearest town)

WELL PURPOSE: HOME
 (home, irrigation, municipal, industrial)

WELL COMPLETION DATA:

- (1) diameter (inches) 2"
- (2) total depth (feet) 160'
- (3) static water level (feet) 60' below top of ground.
- (4) casing Galv 105'
 (material) (depth)
2" if telescope see back.
 (size)
- (5) screen _____
 (length) (depth to top)
 (size) (material)
- (6) pump 1/2 10
 (HP) (yield gpm)
115'
 (type power)
- (7) electric log No
 (yes or no)
N/A
 (organization running log)
- (8) how well bottom plugged OPEN

description of formations encountered

from to

<u>Clay</u>	<u>0</u>	<u>18</u>
<u>Sandy</u>	<u>18</u>	<u>40</u>
<u>Sand & shale</u>	<u>40</u>	<u>70</u>
<u>Sandy</u>	<u>70</u>	<u>80</u>
<u>Shale</u>	<u>80</u>	<u>125</u>
<u>Sand & Rock</u>	<u>125</u>	<u>160</u>


CODED

FEB 2 1973

DRILLERS REMARKS:

If well telescopes please sketch and show depths.

GROUND LEVEL

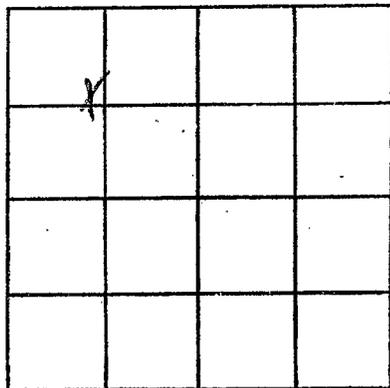

SECTION _____

Please indicate well location X.

ADDITIONAL INFORMATION

If more than one screen, show locations of each on sketch.