

Newton

L 69

3-20-73

MISSISSIPPI
 BOARD OF WATER COMMISSIONERS
 416 North State Street
 Jackson, Mississippi 39201

CODED

WATER WELL DRILLERS LOG

3.20.73

McDonalds + Mill

Newton

date well completed

firm name

county well located

LANDOWNER:

A-C. Embrey

description of formations encountered

from

to

RA 1 Chucky

(mailing address)

Clay

0

10

SAND

10

37

SOFT SHALE

37

50

SAND

50

77

ROCK

77

98

~~SOFT SAND~~

~~98~~

~~105~~

ST SAND

98

105

ROCK HARD SHALE

105

230

SAND

230

260

CODED

WELL LOCATION:

sec. 16 T 60 N

R 12 E

S W

3 miles

N West Chucky

(distance)

(direction)

(nearest town)

WELL PURPOSE:

HOME

(home, irrigation, municipal, industrial)

WELL COMPLETION DATA:

(1) diameter (inches)

4"

(2) total depth (feet)

260'

(3) static water level (feet)

142 below top of ground.

(4) casing

PVC 75'

(material)

(depth)

4"

(size)

if telescope see back.

(5) screen

(length)

(depth to top)

(size)

(material)

(6) pump

2 hp VET 7

(HP)

(yield gpm)

920

(type power)

(7) electric log

(yes or no)

(organization running log)


(8) how well bottom plugged

OPEN

DRILLERS REMARKS:

If well telescopes please sketch and show depths.

GROUND LEVEL

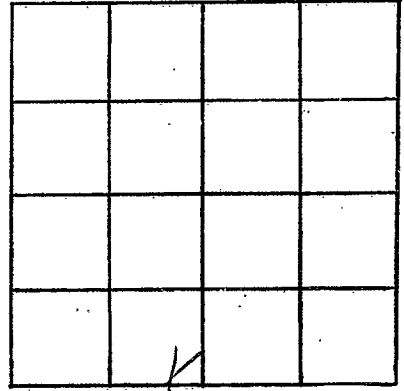

SECTION _____

Please indicate well location X.

ADDITIONAL INFORMATION

If more than one screen,
show locations of each on sketch.