

Newton  
L 68  
3-21-73

MISSISSIPPI  
BOARD OF WATER COMMISSIONERS  
416 North State Street  
Jackson, Mississippi 39201

**CODED**

WATER WELL DRILLERS LOG

3, 21, 73 date well completed  
McDonald + Hill firm name  
Newton county well located

LANDOWNER:  
Austin Lindley  
R#1 Chunky  
(mailing address)

WELL LOCATION:  
sec. 18 T 10 N R 12 E  
4 miles N West Chunky  
(distance) (direction) (nearest town)

WELL PURPOSE: LEONIE  
(home, irrigation, municipal, industrial)

- WELL COMPLETION DATA:
- (1) diameter (inches) 4"
  - (2) total depth (feet) 280'
  - (3) static water level (feet) 80' below top of ground.
  - (4) casing PVC 95' (material) (depth)  
4" (size) if telescope see back.
  - (5) screen (length) (depth to top)  
(size) (material)
  - (6) pump 1 JET 6 (HP) (yield gpm)  
220 (type power)
  - (7) electric log (yes or no)  
(organization running log)
  - (8) how well bottom plugged OPEN


description of formations encountered	from	to
CLAY SAND	0	22
SHALE	22	40
ROCK	40	60
SANDY	60	75
SHALE	75	100
ROCK & SHALE	100	195
SHALE ST SAND	195	220
SANDY	220	260
fine sand	260	270

**CODED**

DRILLERS REMARKS:

If well telescopes please sketch and show depths.

GROUND LEVEL

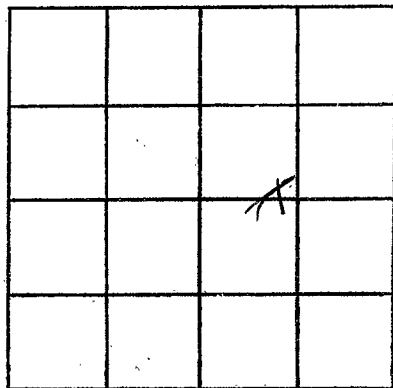

SECTION \_\_\_\_\_

Please indicate well location X.

ADDITIONAL INFORMATION

If more than one screen,  
show locations of each on sketch.