

Newton
L 70
5-1-73

MISSISSIPPI
 BOARD OF WATER COMMISSIONERS
 416 North State Street
 Jackson, Mississippi 39201

CODED

WATER WELL DRILLERS LOG

5-1 19**73** **U. S. Mohler** **Newton**
 date well completed firm name county well located


LANDOWNER:	description of formations encountered	from	to
Mrs. L. H. Holaryd Hickory Miss (mailing address)			
WELL LOCATION:	Grey	16	60
sec. 35 T. 6N R. 12E	Sand	60	118
1 miles NW of Hickory (distance) (direction) (nearest town)	Blue	118	140
WELL PURPOSE: Home (home, irrigation, municipal, industrial)	Brown	140	170
WELL COMPLETION DATA:	Grey & rocky	170	200
(1) diameter (inches) 4"	Sand	200	228
(2) total depth (feet) 360	blue & rocky	228	340
(3) static water level (feet) 50 below top of ground	Sand	340	360
(4) casing 8 pipe 147 (material) (depth)			
(size) If telescope see back.			
(5) screen Open hole (length) (depth to top)			
(size) (material)			
(6) pump 1000 (HP) (yield gpm)			
elec (type power)			
(7) electric log (yes or no)			
(organization running log)			
(8) how well bottom plugged			
DRILLERS REMARKS:			

CODED

11/2 10/2

If well telescopes please sketch and show depths.

GROUND LEVEL

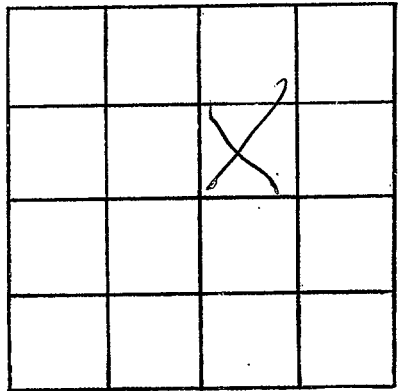

SECTION _____

Please indicate well location X.

ADDITIONAL INFORMATION

If more than one screen,
show locations of each on sketch.