

NEWTON
L 71
7-12-73

MISSISSIPPI
 BOARD OF WATER COMMISSIONERS
 416 North State Street
 Jackson, Mississippi 39201

CODED

WATER WELL DRILLERS LOG

7-12-73 19 Williamson Drilling Co. Newton
 date well completed firm name county well located

LANDOWNER: H. H. Johnson
Decatur Miss

(mailing address)
 WELL LOCATION:
 sec. 4 T. 6N R. 12E
W
1/4 miles south of Decatur
 (distance) (direction) (nearest town)

WELL PURPOSE: Home
 (home, irrigation, municipal, industrial)

- WELL COMPLETION DATA:
- (1) diameter (inches) 4
 - (2) total depth (feet) 345
 - (3) static water level (feet) 90 ^(below) _(above) top of ground.
 - (4) casing metal, 155
 (material) (depth)
4 If telescope see back.
 (size)
 - (5) screen no
 (length) (depth to top)
 (size) (material)
 - (6) pump 1/2 12
 (HP) (yield gpm)
Elect
 (type power)
 - (7) electric log no
 (yes or no)
no
 (organization running log)
 - (8) how well bottom plugged open

description of formations encountered	from	to
<u>top soil</u>	<u>0</u>	<u>3</u>
<u>Red Clay</u>	<u>3</u>	<u>13</u>
<u>Blue Clay</u>	<u>13</u>	<u>45</u>
<u>sand</u>	<u>45</u>	<u>90</u>
<u>Blue Clay</u>	<u>90</u>	<u>260</u>
<u>sand</u>	<u>260</u>	<u>290</u>
<u>Blue Clay</u>	<u>290</u>	<u>320</u>
<u>sand</u>	<u>320</u>	<u>345</u>

CODED


NOV 7 1973

DRILLERS REMARKS:

ALSO SEE OF
 WATER COMMISSIONERS

If well telescopes please sketch and show depths:

GROUND LEVEL

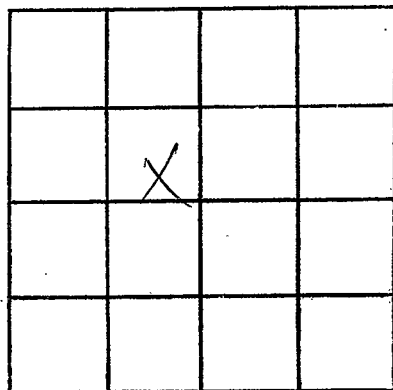

SECTION 4

Please indicate well location X.

ADDITIONAL INFORMATION

If more than one screen,
show locations of each on sketch.