

**NEWTON**  
**L 73**  
**11-6-73**

MISSISSIPPI  
 BOARD OF WATER COMMISSIONERS  
 416 North State Street  
 Jackson, Mississippi 39201 **CODED**

**WATER WELL DRILLERS LOG**

11.6.73 19 McDONALD & HILL NEWTON  
 date well completed firm name county well located

LANDOWNER:  
C. D. TAYLOR  
RH / Hickory  
 (mailing address)

WELL LOCATION:  
 sec 27 T 6 N R 12 E  
2 miles WEST of Hickory  
 (distance) (direction) (nearest town)

WELL PURPOSE: HOME  
 (home, irrigation, municipal, industrial)

- WELL COMPLETION DATA:
- (1) diameter (inches) 4"
  - (2) total depth (feet) 340'
  - (3) static water level (feet) 24' below above top of ground.
  - (4) casing pvc 130  
 (material) (depth)  
4"  
 (size) if telescope see back.
  - (5) screen \_\_\_\_\_  
 (length) (depth to top)  
 \_\_\_\_\_  
 (size) (material)
  - (6) pump 1/2 10  
 (HP) (yield gpm)  
ELECTRIC  
 (type power)
  - (7) electric log \_\_\_\_\_  
 (yes or no)  
 \_\_\_\_\_  
 (organization running log)
  - (8) how well bottom plugged OPEN

description of formations encountered	from	to
CLAY SAND	0	30
SOFT SHALE	30	40
SAND	40	105
SOFT SHALE	105	120
SHALE	120	138
ROCK STR SHELLS	138	150
SAND ST SHALE	150	180
SHALE STR ROCK	180	320
SAND	320	340

**CODED**


NOV 18 1973

MISS. B. & C. WALK GUM

DRILLERS REMARKS:

If well telescopes please sketch and show depths.

GROUND LEVEL

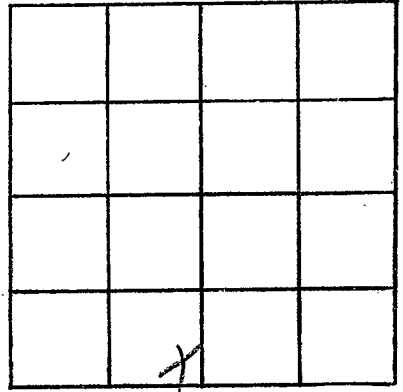

SECTION \_\_\_\_\_

Please indicate well location X.

ADDITIONAL INFORMATION

If more than one screen, show locations of each on sketch.