

**NEWTON**  
**L 74**  
**11-23-73**

**MISSISSIPPI**  
**BOARD OF WATER COMMISSIONERS**  
 416 North State Street  
 Jackson, Mississippi 39201 **CODED**  
**WATER WELL DRILLERS LOG**

11.23.73 date well completed 19 McDONALD & HILL firm name NEWTON county well located

**LANDOWNER:**

TOMMY GRAHAM  
R#1 DECATUR  
 (mailing address)

**description of formations encountered**

from to

CLAY	0	10
SAND	10	80
SHALE	80	125
ROCK ST SHALE	125	140
G SAND	140	150
SAND ST SHALE	150	200

**WELL LOCATION:**

sec. 4 T. 6 N. R. 12 E.  
4 miles S.EAST of DECATUR  
 (distance) (direction) (nearest town)

**WELL PURPOSE:** HOME  
 (home, irrigation, municipal, industrial)

**WELL COMPLETION DATA:**

- (1) diameter (inches) 4 1/4
- (2) total depth (feet) 200'
- (3) static water level (feet) 50' below above top of ground.
- (4) casing PVC 120'  
 (material) (depth)  
4"  
 (size) if telescope see back.
- (5) screen \_\_\_\_\_  
 (length) (depth to top)  
 \_\_\_\_\_  
 (size) (material)
- (6) pump 1/2 SUB 10  
 (HP) (yield gpm)  
ELECTRIC  
 (type power)
- (7) electric log \_\_\_\_\_  
 (yes or no)  
 \_\_\_\_\_  
 (organization running log)
- (8) how well bottom plugged OPEN

**CODED**


NOV 28 1973

MISS. Bd. of  
 WATER COMMISSIONERS

**DRILLERS REMARKS:**

If well telescopes please sketch and show depths.

GROUND LEVEL

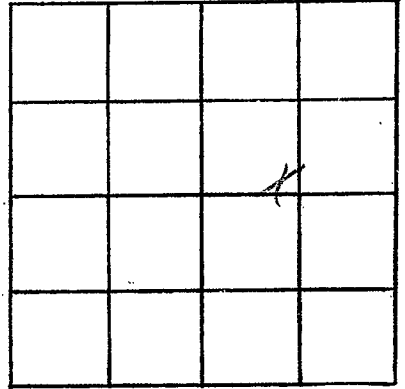

SECTION \_\_\_\_\_

Please indicate well location X.

ADDITIONAL INFORMATION

If more than one screen,  
show locations of each on sketch.