

NEWTON
L75
1-29-74

MISSISSIPPI
BOARD OF WATER COMMISSIONERS
416 North State Street
Jackson, Mississippi 39201

CODED

WATER WELL DRILLERS LOG

1.29.74 19 McDonald + Hill NEWTON
date well completed firm name county well located

LANDOWNER:
LIZZIE KIDD
R# 1 NEWTON
(mailing address)

description of formations encountered	from	to
CLAY	0	20
SAND + CLAY	20	40
SAND	40	75

WELL LOCATION:
sec. 10 T 10 N R 12 E
3 miles NORTH of Hickory
(distance) (direction) (nearest town)

WELL PURPOSE: HOME
(home, irrigation, municipal, industrial)

- WELL COMPLETION DATA:
- (1) diameter (inches) 2"
 - (2) total depth (feet) 75'
 - (3) static water level (feet) 50' below top of ground.
 - (4) casing PVC 64' (material), (depth)
3" if telescope see back. (size)
 - (5) screen 6' 64' (length), (depth to top)
2" PVC (size), (material)
 - (6) pump 1/2 JET 10 (HP), (yield gpm)
ELECTRIC (type power)
 - (7) electric log (yes or no)
(organization running log)
 - (8) how well bottom plugged VALVE

CODED


FEB 1 1974

DRILLERS REMARKS:
1/2 2" LINE CYLINDER
SET JET 63'

MISS. BD. OF WATER COMM

If well telescopes please
sketch and show depths.

GROUND LEVEL

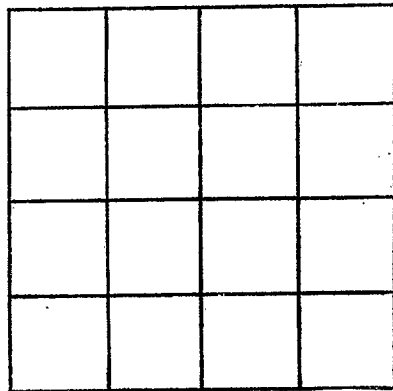

SECTION _____

Please indicate well location X.

ADDITIONAL INFORMATION

If more than one screen,
show locations of each on sketch.