

**NEWTON**  
**L 76**  
**2-27-74**

MISSISSIPPI  
 BOARD OF WATER COMMISSIONERS  
 416 North State Street  
 Jackson, Mississippi 39201

WATER WELL DRILLERS LOG

2. 27. 74  
 date well completed

McDonald + Hill  
 firm name

NEWTON  
 county well located

LANDOWNER:

F. J. FARROW

Hickory

(mailing address)

WELL LOCATION:

sec. 14 T 6 N S R 12 E W  
 3 miles NORTH Hickory  
 (distance) (direction) (nearest town)

WELL PURPOSE:

HOME  
 (home, irrigation, municipal, industrial)


WELL COMPLETION DATA:

- (1) diameter (inches) 4"
- (2) total depth (feet) 300'
- (3) static water level (feet) 51' below top of ground.
- (4) casing PVC 95' (material) (depth)  
 4" (size) if telescope see back.
- (5) screen (length) (depth to top)  
 (size) (material)
- (6) pump 1/2 sub 10 (HP) (yield gpm)  
 ELECTRIC (type power)
- (7) electric log (yes or no)  
 (organization running log)
- (8) how well bottom plugged OPEN

description of formations encountered

from to

CLAY	0	10
SAND+CLAY	10	40
SAND	40	60
SANDY + SHALE	60	70
SHALE	70	95
ROCK ST SHALE	95	120
SAND	120	135
SHALE ST ROCK	135	210
SAND	210	300

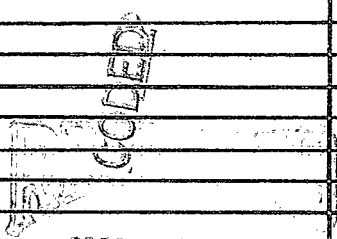

MAR 1 1974

MISS. BD. OF WATER COMMISSIONERS


DRILLERS REMARKS:

If well telescopes please sketch and show depths.

771

L 21  
S. 21

GROUND LEVEL

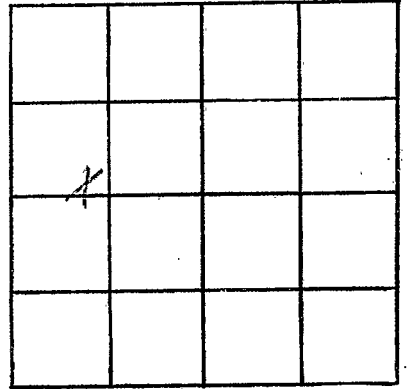

SECTION \_\_\_\_\_

Please indicate well location X.

ADDITIONAL INFORMATION

If more than one screen,  
show locations of each on sketch.