

NEWTON
L77
7-11-74

MISSISSIPPI
 BOARD OF WATER COMMISSIONERS CODED
 416 North State Street
 Jackson, Mississippi 39201

WATER WELL DRILLERS LOG

7-11-74 19 McDonald & Hill NEWTON
 date well completed firm name county well located

LANDOWNER: CARRIE McDONALD
 HICKORY (mailing address)
 description of formations encountered: CLAY, CLAY + SAND, SAND
 from to: 0 18, 18 40, 40 80

WELL LOCATION:
 sec 25 T 6 N R 12 E
 1/2 miles NORTH of HICKORY
 (distance) (direction) (nearest town)

WELL PURPOSE: HOME
 (home, irrigation, municipal, industrial)

CODED

WELL COMPLETION DATA:
 (1) diameter (inches) 2"
 (2) total depth (feet) 80'
 (3) static water level (feet) 30' below top of ground.
 (4) casing PVC 74" (material) (depth)
 2" (size) if telescope see back.
 (5) screen 6 74" (length) (depth to top)
 2" (size) PVC (material)
 (6) pump 1/2 JET 7 (HP) (yield gpm)
 ELECTRIC (type power)
 (7) electric log (yes or no)
 (organization running log)
 (8) how well bottom plugged VALVE


RECEIVED
 JUL 17 1974

MISS. BD. OF WATER COMMISSIONERS

DRILLERS REMARKS:

If well telescopes please sketch and show depths.

GROUND LEVEL

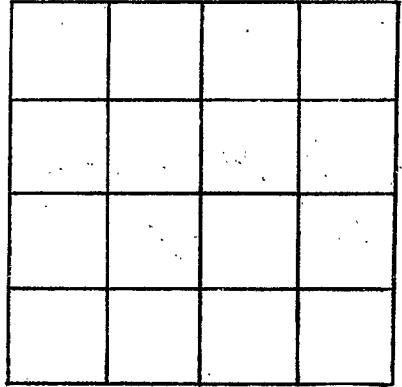

SECTION _____

Please indicate well location X.

ADDITIONAL INFORMATION

If more than one screen,
show locations of each on sketch.