

NEWTON
L 78
7-10-74

MISSISSIPPI
 BOARD OF WATER COMMISSIONERS **CODED**
 416 North State Street
 Jackson, Mississippi 39201

WATER WELL DRILLERS LOG

7.10.74 19 McDONALD Well NEWTON
 date well completed firm name county well located

LANDOWNER:
JANET PATRIDGE
Hickory
 (mailing address)

description of formations encountered	from	to
<u>CLAY</u>	<u>0</u>	<u>26</u>
<u>SAND + CLAY</u>	<u>26</u>	<u>50</u>
<u>SAND</u>	<u>50</u>	<u>90</u>

WELL LOCATION:
 sec 25 T 6 (N) R 12 E
1 1/2 miles W of Hickory
 (distance) (direction) (nearest town)

WELL PURPOSE: HOME
 (home, irrigation, municipal, industrial)

WELL COMPLETION DATA:

- (1) diameter (inches) 2 1/2
- (2) total depth (feet) 90'
- (3) static water level (feet) 40' below top of ground. ~~above~~
- (4) casing 2 1/2" (material) 84' (depth)
2 1/2" (size) if telescope see back.
- (5) screen 6' (length) 84' (depth to top)
2 1/2" (size) PVC (material)
- (6) pump 1/2 JET 8 (HP) 8 (yield gpm)
ELECTRIC (type power)
- (7) electric log _____ (yes or no)
 _____ (organization running log)
- (8) how well bottom plugged VALUE

CODED


RECEIVED
JUL 17 1974

MISS. BD. OF WATER COMM.

DRILLERS REMARKS:

If well telescopes please sketch and show depths.

GROUND LEVEL

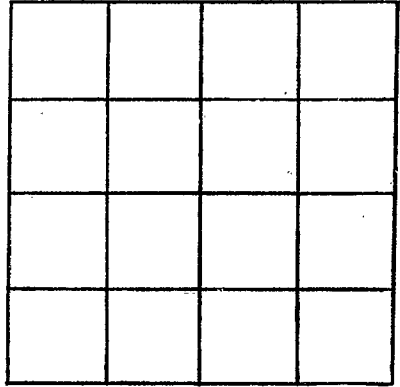

SECTION _____

Please indicate well location X.

ADDITIONAL INFORMATION

If more than one screen, show locations of each on sketch.