

**NEWTON**  
**L 79**  
**8-7-74**

**MISSISSIPPI**  
**BOARD OF WATER COMMISSIONERS**  
 416 North State Street  
 Jackson, Mississippi 39201

**WATER WELL DRILLERS LOG**

**CODED**

8-7-74 19 McDonald + Hill Newton  
 date well completed firm name county well located

**LANDOWNER:**

James McNeil  
Hickory Miss  
 (mailing address)

**WELL LOCATION:**

sec. 10 T. 6N R. 12E  
3 miles NORTH Hickory  
 (distance) (direction) (nearest town)

**WELL PURPOSE:**

(home, irrigation, municipal, industrial)

**WELL COMPLETION DATA:**

- (1) diameter (inches) 4"
- (2) total depth (feet) 320'
- (3) static water level (feet) 64' below ~~above~~ top of ground. #40
- (4) casing PVC 110' #40  
 (material) (depth)  
4" if telescope see back.  
 (size)
- (5) screen \_\_\_\_\_  
 (length) (depth to top)  
 (size) (material)
- (6) pump 1/2 sub 10  
 (HP) (yield gpm)  
ELECTRIC  
 (type power)
- (7) electric log \_\_\_\_\_  
 (yes or no)  
 (organization running log)
- (8) how well bottom plugged OPEN

**description of formations encountered**

from to

Clay	0	20
Sand to Clay	20	78
Shale	78	112
Rock to Shale	112	130
G Sand + Rock	130	150
Shale to Rock	150	285
Sand	285	320


**CODED**

**THE UNIVERSITY OF MISSISSIPPI**  
**WATER CONTROL**  
 AUG 18 1974

**DRILLERS REMARKS:**

If well telescopes please sketch and show depths.

GROUND LEVEL

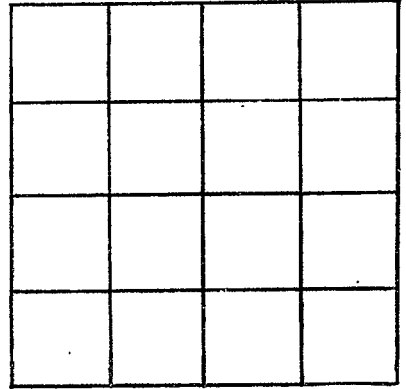

SECTION \_\_\_\_\_

Please indicate well location X.

ADDITIONAL INFORMATION

If more than one screen,  
show locations of each on sketch.