

**NEWTON**  
**L80**  
**12-17-74**

MISSISSIPPI  
 BOARD OF WATER COMMISSIONERS  
 416 North State Street  
 Jackson, Mississippi 39201

**CODED**

**WATER WELL DRILLERS LOG**

12-17-74 date well completed     Williamson Drilling Co. firm name     Newton county well located

LANDOWNER: Greg Wolff  
Hickory Ms.  
Highway 80 West  
 (mailing address)

WELL LOCATION:  
 sec. 35 T. 6N S. R. 12W  
1 miles West of Hickory  
 (distance) (direction) (nearest town)

WELL PURPOSE: Home  
 (home, irrigation, municipal, industrial)

- WELL COMPLETION DATA:
- (1) diameter (inches) \_\_\_\_\_
  - (2) total depth (feet) 370
  - (3) static water level (feet) 50 <sup>below</sup> / <sub>above</sub> top of ground.
  - (4) casing metal (material), 144 (depth)
  - \_\_\_\_\_ (size) If telescope see back.
  - (5) screen no (length) \_\_\_\_\_ (depth to top)
  - \_\_\_\_\_ (size) \_\_\_\_\_ (material)
  - (6) pump 1/2 (HP), 12 (yield gpm)
  - Elect. (type power)
  - (7) electric log no (yes or no)
  - no (organization running log)
  - (8) how well bottom plugged open

description of formations encountered	from	to
top soil	0	1
red clay	1	8
red sand	8	31
white sand	31	65
blue clay	65	90
sand	90	138
crack clay	138	310
sand	310	370


**REGISTERED**  
**SEPT 18 1974**

MISS. Bd. OF WATER COMMISSIONERS

DRILLERS REMARKS: \_\_\_\_\_

If well telescopes please sketch and show depths.

GROUND LEVEL

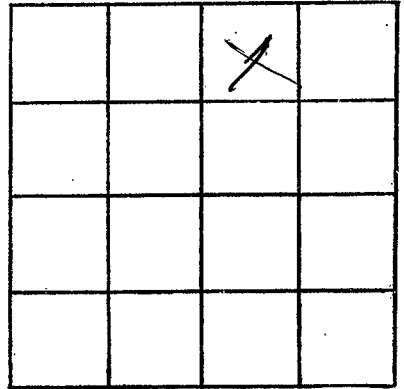

SECTION 35

Please indicate well location X.

ADDITIONAL INFORMATION

If more than one screen, show locations of each on sketch.