

NEWTON  
L 82  
S-23-75

MISSISSIPPI  
 BOARD OF WATER COMMISSIONERS  
 416 North State Street  
 Jackson, Mississippi 39201

CODED

WATER WELL DRILLERS LOG CODED

5.23.75 19 MCDONALD & HILL NEWTON  
 date well completed firm name county well located

LANDOWNER:  
LARRY MANN  
NEWTON  
 (mailing address)

description of formations encountered	from	to
<u>CLAY</u>	<u>0</u>	<u>16</u>
<u>YELLOW SAND</u>	<u>16</u>	<u>145</u>
<u>SOFT SANDS</u>	<u>145</u>	<u>165</u>
<u>SHALE</u>		
<u>SHALE</u>	<u>165</u>	<u>193</u>
<u>ROCK STRATUM</u>	<u>193</u>	<u>210</u>
<u>GREEN SAND</u>	<u>210</u>	<u>270</u>

WELL LOCATION:  
 sec. 27 T. 5 N. R. 12 E.  
4 miles EAST of NEWTON  
 (distance) (direction) (nearest town)

WELL PURPOSE: HOUSE  
 (home, irrigation, municipal, industrial)

- WELL COMPLETION DATA:
- diameter (inches) 4"
  - total depth (feet) 240'
  - static water level (feet) 55' below top of ground.
  - casing PVC, 175' (material) (depth)  
4" (size) if telescope see back.
  - screen \_\_\_\_\_ (length) \_\_\_\_\_ (depth to top)  
 \_\_\_\_\_ (size) \_\_\_\_\_ (material)
  - pump 1/2 sub 10 (HP) (yield gpm)  
ELECTRIC (type power)
  - electric log \_\_\_\_\_ (yes or no)  
 \_\_\_\_\_ (organization running log)
  - how well bottom plugged DOEN

CODED


RECEIVED  
 JUN 6 1975

MISS. BD. OF WATER COMMISSIONERS

DRILLERS REMARKS:

If well telescopes please sketch and show depths.

GROUND LEVEL

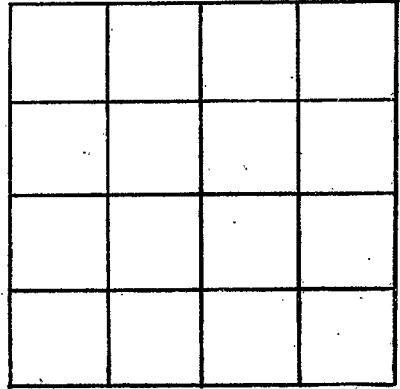

SECTION \_\_\_\_\_

Please indicate well location X.

ADDITIONAL INFORMATION

If more than one screen, show locations of each on sketch.