

Newton  
L 83  
7-21-75

MISSISSIPPI  
 BOARD OF WATER COMMISSIONERS  
 416 North State Street  
 Jackson, Mississippi 39201

CODED

WATER WELL DRILLERS LOG

7.21.75  
 date well completed

McDONALD + HILL  
 firm name

NEWTON  
 county well located

LANDOWNER:  
W. A. ALTMAN  
Chunke, Miss  
 (mailing address)

WELL LOCATION:  
 sec. 14 T. 6N R. 12E 13P  
2 miles North of Hickory  
 (distance) (direction) (nearest town)

description of formations encountered	from	to
<u>CLAY</u>	<u>0</u>	<u>16</u>
<u>SHALE STROCK</u>	<u>16</u>	<u>112</u>
<u>SHALE</u>	<u>112</u>	<u>140</u>
<u>COURSE SAND</u>	<u>140</u>	<u>180</u>

WELL PURPOSE: HOUSING  
 (home) irrigation, municipal, industrial

CODED

WELL COMPLETION DATA:

(1) diameter (inches) 4"

(2) total depth (feet) 180'

(3) static water level (feet) 50' below top of ground

(4) casing pc 80'  
 (material) (depth)  
4u if telescope see back.  
 (size)

(5) screen \_\_\_\_\_  
 (length) (depth to top)  
 (size) (material)

(6) pump 1/2 10  
 (HP) (yield gpm)  
E  
 (type power)

(7) electric log \_\_\_\_\_  
 (yes or no)  
 (organization running log)

(8) how well bottom plugged OPEN


DIGITAL  
 28 19 75

DRILLERS REMARKS:

MISS. BD. OF WATER

If well telescopes please  
sketch and show depths.

GROUND LEVEL

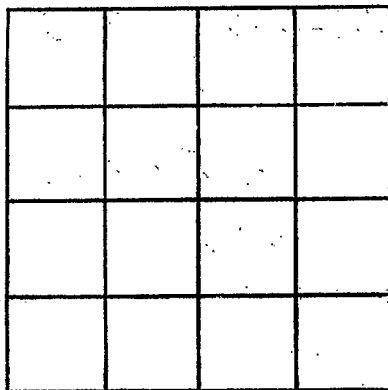

SECTION \_\_\_\_\_

Please indicate well location X.

ADDITIONAL INFORMATION

If more than one screen,  
show locations of each on sketch.