

Newton
L 84
7-21-75

MISSISSIPPI
BOARD OF WATER COMMISSIONERS
416 North State Street
Jackson, Mississippi 39201

CODED

WATER WELL DRILLERS LOG

7.21.75 19 Mc Donald + Hest Newton
date well completed firm name county well located

LANDOWNER:	description of formations encountered	from	to
H O HURST	CLAY	0	16
Hickory, Miss (mailing address)	Sand + Clay	16	40
WELL LOCATION: 12 13P sec. 23 T. 6N R. 12E S 5	fine sand + clay	40	68
2 miles North Hickory (distance) (direction) (nearest town)	COURSE SAND	68	78
WELL PURPOSE: HOME (home, irrigation, municipal, industrial)			
WELL COMPLETION DATA:			
(1) diameter (inches) 2 1/2			
(2) total depth (feet) 78'			
(3) static water level (feet) 36' below top of ground.			
(4) casing PVC 73' (material) (depth) 2" if telescope see back. (size)			
(5) screen 5' 73' (length) (depth to top) 2" PVC (size) (material)			
(6) pump 1 HP 10 (HP) (yield gpm) E (type power)			
(7) electric log _____ (yes or no) (organization running log)			
(8) how well bottom plugged VALVE			
DRILLERS REMARKS:			


CODED

RECEIVED
JUL 28 1975

MISS. BD. OF WATER COMM.

If well telescopes please sketch and show depths.

GROUND LEVEL

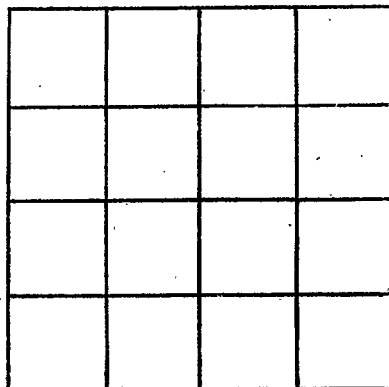

SECTION _____

Please indicate well location X.

ADDITIONAL INFORMATION

If more than one screen,
show locations of each on sketch.