

Newton
L 85
8-14-75

MISSISSIPPI
BOARD OF WATER COMMISSIONERS
416 North State Street
Jackson, Mississippi 39201


CODED

WATER WELL DRILLERS LOG

8.14.75 19 McDonald & Son Newton MS
date well completed firm name county well located

LANDOWNER:	description of formations encountered	from	to
NEVA NORMAN			
R# 2 DECATUR (mailing address)	Sand	12	95
WELL LOCATION: sec. 26 T. 6 N. R. 18 E. 13 P.	Soft sandy	95	110
2.0 miles North of Hickory (distance) (direction) (nearest town)	Shale	110	145
WELL PURPOSE: (home, irrigation, municipal, industrial)	Sand & Shale 1st Rock	145	195
WELL COMPLETION DATA:			
(1) diameter (inches) 4 1/2			
(2) total depth (feet) 195			
(3) static water level (feet) 65' below top of ground.			
(4) casing PVC 130 (material) (depth)			
4" If telescope see back. (size)			
(5) screen _____ (length) (depth to top)			
(size) _____ (material)			
(6) pump 1/2 10 (HP) (yield gpm)			
F (type power)			
(7) electric log _____ (yes or no)			
_____ (organization running log)			
(8) how well bottom plugged OPEN			
DRILLERS REMARKS:			


CODED

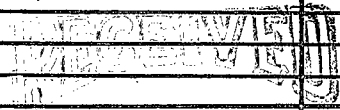

MISS 1 8 1976
MISS 1 8 1976

If well telescopes please sketch and show depths.

GROUND LEVEL

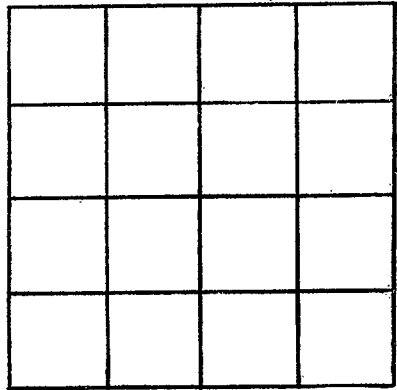

SECTION _____

Please indicate well location X.

ADDITIONAL INFORMATION

If more than one screen, show locations of each on sketch.