

NEWTON
L 96
4-23-76

MISSISSIPPI
 BOARD OF WATER COMMISSIONERS
 416 North State Street
 Jackson, Mississippi 39201 **CODED**

WATER WELL DRILLERS LOG

4.23.76 19 McDONALD + HILL NEWTON
 date well completed firm name county well located

LANDOWNER:
USDA
Coastal Plains Exp. Station
Newton, miss
 (mailing address)

WELL LOCATION:
 sec. 28 T. 6 N. R. 12 E
5 miles WEST of Hickory
 (distance) (direction) (nearest town)

WELL PURPOSE:
 (home, irrigation, municipal, industrial)


- WELL COMPLETION DATA:
- (1) diameter (inches) 4"
 - (2) total depth (feet) 250'
 - (3) static water level (feet) 36' below top of ground.
 - (4) casing pvc, 192'
 (material) (depth)
4" if telescope see back.
 (size)
 - (5) screen 15', 230'
 (length) (depth to top)
2", pvc
 (size) (material)
 - (6) pump 5, 50
 (HP) (yield gpm)
E
 (type power)
 - (7) electric log —
 (yes or no)
—
 (organization running log)
 - (8) how well bottom plugged VALUE

description of formations encountered	from	to
Clay	0	10
hard Clay	10	38
Clay	38	65
hard	65	145
Shale	145	200
Rock str shells	200	230
hard	230	245
sandy	245	250
CODED		
RECEIVED		
APR 28 1976		
MISS. ED		
COMMI		

DRILLERS REMARKS:

If well telescopes please sketch and show depths.

GROUND LEVEL

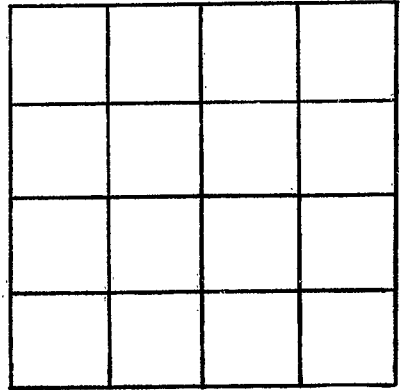

SECTION _____

Please indicate well location X.

ADDITIONAL INFORMATION

If more than one screen,
show locations of each on sketch.