

MISSISSIPPI DEPARTMENT OF NATURAL RESOURCES

Bureau of Land and Water Resources

Southport Mall

P.O. Box 10631

Jackson, Mississippi 39209

WATER WELL DRILLERS LOG

L88
 NEWTON
 5-4-84

CODED

5-4-84 19 McDonalds Mill Newton
 date well completed firm name county well located

LANDOWNER:
Deater Development Club
Deater
 (mailing address)

WELL LOCATION:
 sec. 6 T. 16 N. R. 12 E
1 1/2 miles 5 of Deater
 (distance) (direction) (nearest town)

WELL PURPOSE: chance
 (home, irrigation, municipal, industrial)

WELL COMPLETION DATA:

(1) diameter (inches) 4"

(2) total depth (feet) 320'

(3) static water level (feet) 100' Below top of ground.

(4) casing PVC 300'
 (material) (depth)
4" If telescope see back.
 (size)

(5) screen 20' 300 to 320'
 (length) (depth to top)
3/8" PVC
 (size) (material)

(6) pump 2 23 GPM
 (HP) (yield/gpm)
P
 (type power)

(7) electric log
 (yes or no)

 (organization running log)

(8) how well bottom plugged unplugged

description of formations encountered	from	to
clay	0	10
sand st clay	10	100
shale	100	125
Rock & shells	125	150
green sandy shaly shale	150	160
Rocky shale	160	285
shale st sand	285	295
sand	295	320

DEPT. OF NATURAL RESOURCES
 BUREAU OF LAND & WATER RESOURCES


MAY 14 1984

RECEIVED

DRILLERS REMARKS:

If well telescopes please
sketch and show depths.

GROUND LEVEL

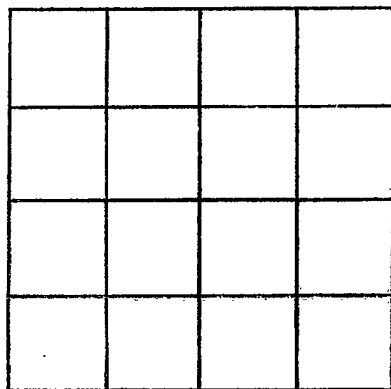

SECTION _____

Please indicate well location X.

ADDITIONAL INFORMATION

If more than one screen,
show locations of each on sketch.