

MISSISSIPPI DEPARTMENT OF NATURAL RESOURCES

Bureau of Land and Water Resources

Southport Mall

P.O. Box 10631

Jackson, Mississippi 39209

WATER WELL DRILLERS LOG

289
Newton

5-1 1985 McDonald + Hill Newton  
 date well completed firm name county well located

LANDOWNER: L.M. Dudley  
1901 Hwy 45N  
Meridian, MS  
 (mailing address)

WELL LOCATION:  
 sec. 36T 10N R. 12E  
2 miles North of Hickory  
 (distance) (direction) (nearest town)

WELL PURPOSE: none  
 (home, irrigation, municipal, industrial)

- WELL COMPLETION DATA:
- (1) diameter (inches) 4"
  - (2) total depth (feet) 337
  - (3) static water level (feet) 63 below top of ground
  - (4) casing 4" PC, 140'  
 (material) (depth)  
 (size) If telescope see back.
  - (5) screen NO  
 (length) (depth to top)  
 (size) (material)
  - (6) pump \_\_\_\_\_ (HP) \_\_\_\_\_ (yield gpm)  
 (type power)
  - (7) electric log \_\_\_\_\_  
 (yes or no)  
 (organization running log)
  - (8) how well bottom plugged open ml

description of formations encountered	from	to
Clay + sand	0	90
sandy shale	90	115
Sandy st Rock	115	150
Coarse green sand	150	180
Rock + shale	180	188
Coars sand	188	318
	318	337


RECEIVED  
 MAY - 7 1985

Department of Natural Resources  
 Bureau of Land & Water Resources

DRILLERS REMARKS:

If well telescopes please sketch and show depths.

GROUND LEVEL

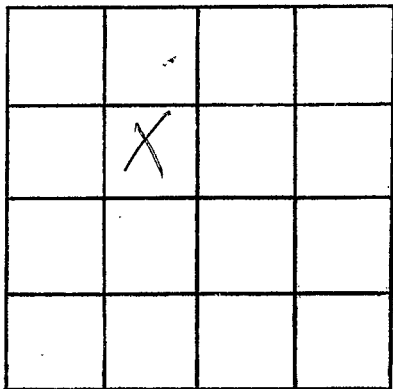

SECTION 36

Please indicate well location X.

ADDITIONAL INFORMATION

If more than one screen,  
show locations of each on sketch.