

MISSISSIPPI DEPARTMENT OF NATURAL RESOURCES

Bureau of Land and Water Resources

Southport Mall

P.O. Box 10631

Jackson, Mississippi 39209

WATER WELL DRILLERS LOG

690
Newton

5- 19 85 McDonald + Hill Newton
date well completed firm name county well located

LANDOWNER: David Thomas

P.O. Box 453

Newton, MS
(mailing address)

description of formations encountered

from

to

Clay + sand 0 20
Coarse sand 20 137

WELL LOCATION:

sec 9 T 6 N R 17 E
4 miles north of Hickory
(distance) (direction) (nearest town)

WELL PURPOSE: Home
(home, irrigation, municipal, industrial)

WELL COMPLETION DATA:

- (1) diameter (inches) 2
- (2) total depth (feet) 137
- (3) static water level (feet) 46 below above top of ground.
- (4) casing 2" PVC 128'
(material) (depth)

_____ if telescope see back.
(size)

- (5) screen 10' 2" PVC + HO 5/8"
(length) (depth to top) (size) (material)

- (6) pump _____ 10
(HP) (yield gpm)


_____ (type power)

- (7) electric log _____ (yes or no)

_____ (organization running log)


- (8) how well bottom plugged 1-2" back pressure valve

DRILLERS REMARKS:

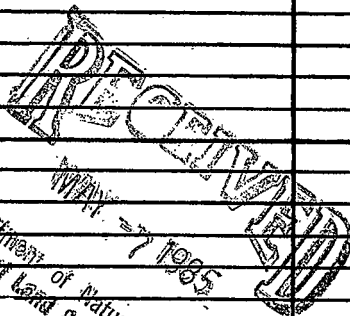

If well telescopes please sketch and show depths.

GROUND LEVEL

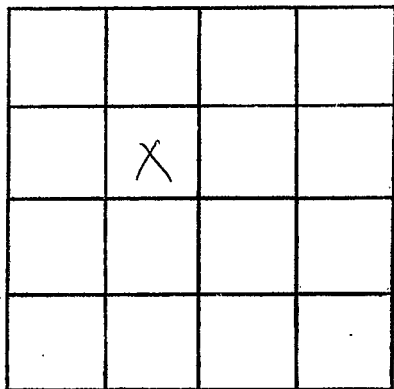

SECTION 9

Please indicate well location X.

ADDITIONAL INFORMATION

If more than one screen,
show locations of each on sketch.