

MISSISSIPPI DEPARTMENT OF NATURAL RESOURCES

Bureau of Land and Water Resources

Southport Mall

P.O. Box 10631

Jackson, Mississippi 39209

WATER WELL DRILLERS LOG

NEWTON
L 95
8966

Added

July 25 1990 Layne-Central Co. Newton
 date well completed firm name county well located


LANDOWNER: Town of Hickory
Well #2 (South)
P.O. Box 10
Hickory, MS 39332
 (mailing address)

WELL LOCATION:
 sec. 9 T. 6 N R. 12 E
NW 1/4 of SE 1/4
 (distance) miles (direction) of (nearest town)

WELL PURPOSE: Municipal
 (home, irrigation, municipal, industrial)

WELL COMPLETION DATA:
 (1) diameter (inches) 12"
 (2) total depth (feet) 461'
 (3) static water level (feet) 192' below above top of ground.
 (4) casing Steel 420'
 (material) (depth)
12" if telescope see back.
 (size) +60' of 8"
 (5) screen 30' 425'
 (length) (depth to top)
8" Stainless Steel
 (size) (material)
 (6) pump 40 300
 (HP) (yield gpm)
230 volts
 (type power)
 (7) electric log Yes
 (yes or no)
Layne-Central Co.
 (organization running log)
 (8) how well bottom plugged 6" Back
Pressure Valve

description of formations encountered	from	to
Red Clay & Sand	0	20'
Blue & Brown & White Clay	20'	73'
Loose Sand & Shale	73'	83'
Fine Sand	83'	135'
Sand & Gravel	135'	147'
Coarse Sand & Clay streaks	147'	211'
Blue Clay & Hard Shale streaks	211'	336'
Rock	336'	337'
Blue Clay & Hard Shale	337'	354'
Rock	354'	355'
Blue Clay & Hard Shale	355'	422'
Sand w/ lignite & Shale streaks	422'	461'
Blue Clay & Hard Shale	461'	483'

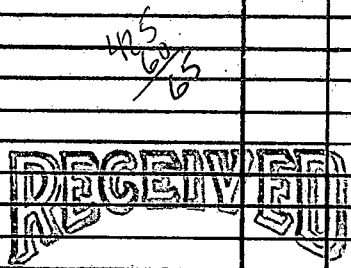


MAR 26 1991

Dept. of Environmental Quality
 Bureau of Land & Water Resources

DRILLERS REMARKS:
Permit # 08966

If well telescopes please sketch and show depths.

GROUND LEVEL

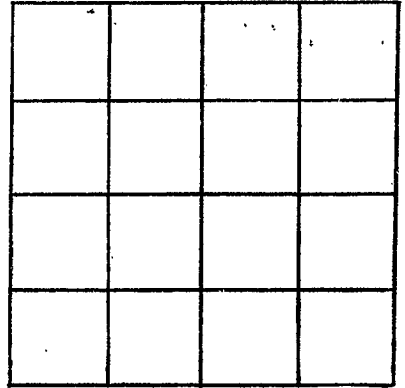

SECTION _____

Please indicate well location X.

ADDITIONAL INFORMATION

If more than one screen,
show locations of each on sketch.