

MISSISSIPPI DEPARTMENT OF NATURAL RESOURCES

Bureau of Land and Water Resources

Southport Mall

P.O. Box 10631

Jackson, Mississippi 39209

WATER WELL DRILLERS LOG

NEWTON
L 96
8965

Coded

July 17 19 80
date well completed

Laune-Central Co.
firm name

Newton
county well located

LANDOWNER: Town of Hickory
Well # 1-North; (Nearest Tank)
P.O. Box 10

description of formations encountered

from to

Hickory, MS 39332
(mailing address)

Red Clay	0	20'
Blue Sandy Clay	20'	53'
Brown & White Clay	53'	90'
Sand & Clay Streaks	90'	223'
Clay	223'	259'
Rock	259'	260'
Clay & Shale	260'	281'
Rock	281'	283'
Hard Shale & Clay Stks	283'	333'
Rock	333'	334'
Hard Shale & Clay Stks	334'	423'
Sand w/ Shale Streaks	423'	459'
Sandy Clay	459'	463'

WELL LOCATION:

sec. 9 T. 6 N R. 12 E
NW 1/4, SE 1/4
miles of (nearest town)

WELL PURPOSE: Municipal
(home, irrigation, municipal, industrial)


WELL COMPLETION DATA:

- diameter (inches) 12"
- total depth (feet) 461'
- static water level (feet) 184' below top of ground.
- casing Steel (material), 421' (depth)
12" (size) if telescope see back.
60' of 8"
- screen 30' (length), 426' (depth to top)
8" (size), Stainless Steel (material)
- pump 40 (HP), 300 (yield gpm)
230 volts (type power)
- electric log Yes (yes or no)
Laune-Central Co. (organization running log)
- how well bottom plugged 6" Back
Pressure Valve

426
- 60

366
426
- 30

396

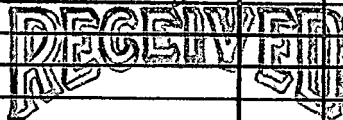

MAR 26 1991

Dept. of Environmental Quality
Bureau of Land & Water Resources

DRILLERS REMARKS:

Permit # 08965

If well telescopes please sketch and show depths.

GROUND LEVEL

SECTION _____

Please indicate well location X.

ADDITIONAL INFORMATION

If more than one screen,
show locations of each on sketch.