

Newton
L 2000
12-10-75

MISSISSIPPI
 BOARD OF WATER COMMISSIONERS
 416 North State Street
 Jackson, Mississippi 39201

WATER WELL DRILLERS LOG

12.10.75
 date well completed

McDonald + Kiel
 firm name

NEWTON
 county well located

LANDOWNER:
Phillip Bonds
R. L. Nichols
 (mailing address)

WELL LOCATION:
 sec. 1 T. 6N R. 12E
4 miles North of Nichols
 (distance) (direction) (nearest town)

WELL PURPOSE:
Home
 (home, irrigation, municipal, industrial)

WELL COMPLETION DATA:
 (1) diameter (inches) 4 1/2
 (2) total depth (feet) 280'
 (3) static water level (feet) 9.5' below above top of ground.
 (4) casing PVC 102'
 (material) (depth)
4"
 (size) If telescope see back.
 (5) screen _____
 (length) (depth to top)
 (size) (material)
 (6) pump 1/2 sub 6
 (HP) (yield gpm)
E
 (type power)
 (7) electric log _____
 (yes or no)
 (organization running log)
 (8) how well bottom plugged OPEN


description of formations encountered	from	to
Clay	0	16
Sand	16	55
Soft shale	55	72
Shale	72	104
Hard shale	104	120
Residual sand	120	135
Hard. Shale	135	260
Sand	260	280

DRILLERS REMARKS:
SET PUMP 130'

DEC 24 1975
 MISS. BUREAU OF WATER CONTROL

If well telescopes please sketch and show depths.

GROUND LEVEL

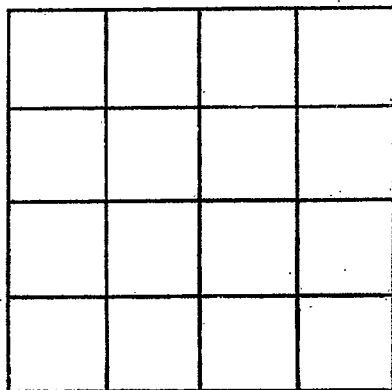

SECTION _____

Please indicate well location X.

ADDITIONAL INFORMATION

If more than one screen, show locations of each on sketch.