

Newton
L 2001
12-31-75

MISSISSIPPI
 BOARD OF WATER COMMISSIONERS
 416 North State Street
 Jackson, Mississippi 39201

WATER WELL DRILLERS LOG

12.31.75 ^{13P} McDONALD HILL NEWTON
 date well completed firm name county well located

LANDOWNER:
DAVID NORMAN
Rt 1 NEWTON
 (mailing address)

WELL LOCATION:
 sec. 18 T. 6 N. R. 12 E
3 miles NORTH of NEWTON
 (distance) (direction) (nearest town)

WELL PURPOSE: HOME
 (home, irrigation, municipal, industrial)

WELL COMPLETION DATA:

(1) diameter (inches) 4"

(2) total depth (feet) 320'

(3) static water level (feet) 80' below top of ground.
above

(4) casing pvc 250'
 (material) (depth)
4"
 (size) If telescope see back.

(5) screen _____
 (length) (depth to top)
 (size) (material)

(6) pump _____ (HP) _____ (yield gpm)
ELECTRIC
 (type power)

(7) electric log _____
 (yes or no)
 (organization running log)

(8) how well bottom plugged OPEN

description of formations encountered	from	to
Clay Sand	0	19
Blue Clay	19	40
Rock	40	41
Shale	41	90
Sand	90	112
Shale	112	140
Sand	140	205
SHALE	205	214
Sand	214	228
Rock	228	230
Salt Flak	230	240
Shale	240	270
Rock Shale	270	290
Sand	290	320


REGISTERED
 DRILLERS LOG
 JAN 12 1976

MISS. BD. OF WATER COM.

DRILLERS REMARKS:

If well telescopes please sketch and show depths.

GROUND LEVEL

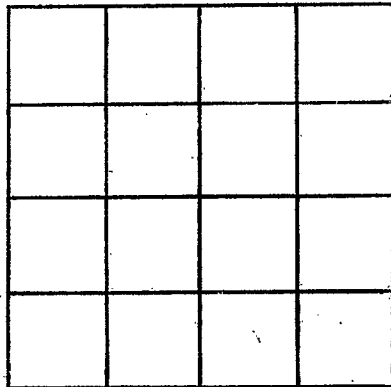

SECTION _____

Please indicate well location X.

ADDITIONAL INFORMATION

If more than one screen, show locations of each on sketch.