

NEWTON
 L 2002
 5-10-76

MISSISSIPPI
 BOARD OF WATER COMMISSIONERS
 416 North State Street
 Jackson, Mississippi 39201

WATER WELL DRILLERS LOG

5-10-76 13P date well completed
 Williamson Drilling Co. firm name
 Newton county well located

LANDOWNER: William T Chaney
 #12
Hickory, Miss.
 (mailing address)

| description of fomations encountered | from | to |
|--------------------------------------|------|-----|
| top soil | 0 | 3 |
| red clay | 3 | 8 |
| red sand | 8 | 16 |
| brided gravel & clay | 16 | 265 |
| sand | 265 | 305 |

WELL LOCATION:
 sec. 13 T. 6 N. R. 12 E.
3 miles N of Hickory
 (distance) (direction) (nearest town)

WELL PURPOSE: Home
 (home, irrigation, municipal, industrial)


- WELL COMPLETION DATA:
- (1) diameter (inches) 4
 - (2) total depth (feet) 305
 - (3) static water level (feet) 90 ^{below} top of ground.
 - (4) casing PVC 160
 (material) (depth)
4 if telescope see back.
 (size)
 - (5) screen no
 (length) (depth to top)
 (size) (material)
 - (6) pump 1 6
 (HP) (yield gpm)
Electric
 (type power)
 - (7) electric log no
 (yes or no)
no
 (organization running log)
 - (8) how well bottom plugged: open

DRILLERS REMARKS:

RECEIVED
 MAY 26 1976
 MISS. Bd. of WATER COMMISSIONERS

If well telescopes please sketch and show depths.

GROUND LEVEL

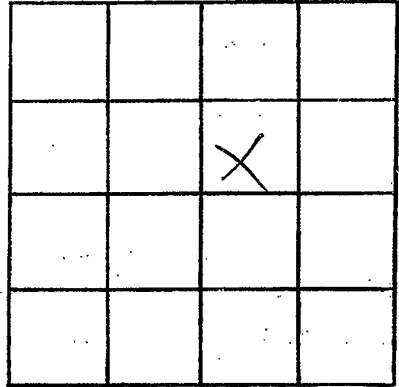

SECTION 13

Please indicate well location X.

ADDITIONAL INFORMATION

If more than one screen, show locations of each on sketch.