

**MISSISSIPPI
BOARD OF WATER COMMISSIONERS**
416 North State Street
Jackson, Mississippi 39201

WATER WELL DRILLERS LOG

Newton
L 2003
8-18-76

13P

8-18 1976 L. S. Caldwell Newton
date well completed firm name county well located

LANDOWNER:
Lamar Caldwell
Hickory Miss
(mailing address)

description of formations encountered

description of formations encountered	from	to
<u>red clay</u>	<u>0</u>	<u>18</u>
<u>loam</u>	<u>18</u>	<u>65</u>

WELL LOCATION:
sec. 4 T. 60N R. 12E
5 miles N. of Hickory
(distance) (direction) (nearest town)

<u>Block</u>	<u>65</u>	<u>115</u>
<u>Blue Rock</u>	<u>115</u>	<u>280</u>

WELL PURPOSE: Home
(home, irrigation, municipal, industrial)

<u>Sand</u>	<u>280</u>	<u>300</u>
-------------	------------	------------

WELL COMPLETION DATA:

(1) diameter (inches) 3"

(2) total depth (feet) 300

(3) static water level (feet) 74 below/above top of ground.

(4) casing PVC 130
(material) (depth)

_____ If telescope see back.
(size)

(5) screen Open Hole
(length) (depth to top)

_____ (size) _____ (material)

(6) pump 1 300 PH
(HP) (yield gpm)

elec
(type power)

(7) electric log _____
(yes or no)

_____ (organization running log)

(8) how well bottom plugged _____


DRILLERS REMARKS:

RECEIVED
SEP - 3 1976

MISS. Bd. OF WATER COMMISSIONERS

If well telescopes please sketch and show depths.

GROUND LEVEL

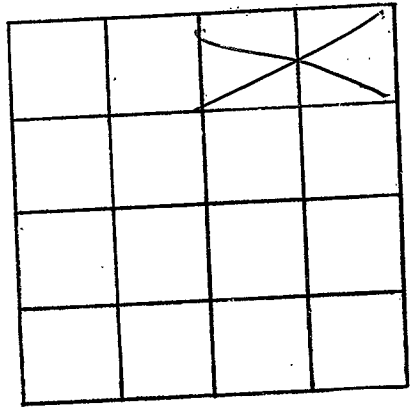

SECTION _____

Please indicate well location X.

ADDITIONAL INFORMATION

If more than one screen,
show locations of each on sketch.