

NEWTON
6 2004
9-22-76

MISSISSIPPI
 BOARD OF WATER COMMISSIONERS
 416 North State Street
 Jackson, Mississippi 39201

WATER WELL DRILLERS LOG

9. 22.76 ^{13P} McDONALD + HILL NEWTON
 date well completed firm name county well located


LANDOWNER:	description of formations encountered	from	to
<u>FLORA GLASPY</u>		<u>Clay sand</u>	<u>0</u>
<u>R# 2 DECATOR</u> (mailing address)	<u>sand</u>	<u>26</u>	<u>65</u>
WELL LOCATION:	<u>Clay</u>	<u>65</u>	<u>68</u>
sec. <u>10</u> T. <u>6</u> N. R. <u>13</u> E	<u>Course sand</u>	<u>68</u>	<u>120</u>
<u>4 1/2</u> miles <u>SEAST</u> of <u>DECATOR</u>	<u>Blue Clay</u>	<u>120</u>	
(distance) (direction) (nearest town)			
WELL PURPOSE: <u>HO WIL</u> (home, irrigation, municipal, industrial)			
WELL COMPLETION DATA:			
(1) diameter (inches) <u>2"</u>			
(2) total depth (feet) <u>120'</u>			
(3) static water level (feet) <u>56'</u> below above top of ground.			
(4) casing <u>PVC</u> <u>115</u> (material) (depth)			
<u>2"</u> (size) if telescope see back.			
(5) screen <u>5'</u> <u>115</u> (length) (depth to top)			
<u>2"</u> <u>PVC #14</u> (size) (material)			
(6) pump <u>1/2 JET</u> <u>10</u> (HP) (yield gpm)			
<u>E</u> (type power)			
(7) electric log (yes or no) _____			
(organization running log) _____			
(8) how well bottom plugged <u>VALUE</u>			
DRILLERS REMARKS:			

RECEIVED
 SEP 24 1976

MISS. BD. OF WATER COMM

If well telescopes please sketch and show depths.

GROUND LEVEL

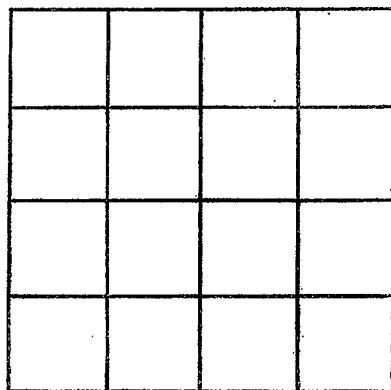

SECTION _____

Please indicate well location X.

ADDITIONAL INFORMATION

If more than one screen, show locations of each on sketch.