

Newton
L 2005
10-15-76

MISSISSIPPI
 BOARD OF WATER COMMISSIONERS
 416 North State Street
 Jackson, Mississippi 39201

WATER WELL DRILLERS LOG

10-15 1976 McDonald & Hill Newton
 date well completed firm name county well located


LANDOWNER:	description of formations encountered	from	to
<u>Inda Norman</u>			
<u>Rt 1 Newton</u> (mailing address)	<u>shale</u>	<u>11</u>	<u>23</u>
WELL LOCATION:	<u>shale st sand</u>	<u>25</u>	<u>45</u>
sec. <u>19</u> T. <u>6</u> N. R. <u>12</u> E	<u>sand</u>	<u>45</u>	<u>65</u>
<u>3</u> miles <u>NE</u> of <u>Newton</u>	<u>shale</u>	<u>65</u>	<u>80</u>
(distance) (direction) (nearest town)	<u>shale st sand</u>	<u>80</u>	<u>90</u>
WELL PURPOSE:	<u>shale</u>	<u>90</u>	<u>140</u>
<u>Home</u> (home, irrigation, municipal, industrial)	<u>sand</u>	<u>140</u>	<u>180</u>
WELL COMPLETION DATA:	<u>sandy shale & sand</u>	<u>180</u>	<u>210</u>
(1) diameter (inches) <u>4"</u>	<u>shale</u>	<u>210</u>	<u>245</u>
(2) total depth (feet) <u>300'</u>	<u>Rock st shale</u>	<u>245</u>	<u>270</u>
(3) static water level (feet) <u>75'</u> below above top of ground.	<u>sand + shale + st Rock</u>	<u>270</u>	<u>300</u>
(4) casing <u>PVC</u> , <u>225'</u> (material) (depth)			
<u>1 1/2"</u> (size) If telescope see back.			
(5) screen _____ (length) (depth to top)			
(size) (material)			
(6) pump <u>1</u> <u>10</u> (HP) (yield gpm)			
(type power)			
(7) electric log <u>yes</u> (yes or no)			
(organization running log)			
(8) how well bottom plugged <u>open</u>			
DRILLERS REMARKS:			

RECEIVED
 OCT 26 1976

MISS. BD. OF WATER COMMISSIONERS

If well telescopes please sketch and show depths.

GROUND LEVEL

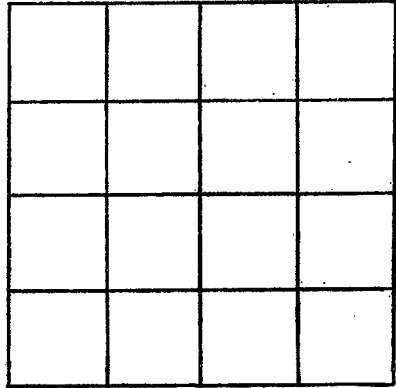

SECTION _____

Please indicate well location X.

ADDITIONAL INFORMATION

If more than one screen, show locations of each on sketch.