

Newton  
L 2006  
10-18-76

MISSISSIPPI  
 BOARD OF WATER COMMISSIONERS  
 416 North State Street  
 Jackson, Mississippi 39201

WATER WELL DRILLERS LOG

10-18-76 <sup>13P</sup> McDonalds Hill Newton  
 date well completed firm name county well located

LANDOWNER:	description of formations encountered	from	to
<u>Edward Buckley</u>			
<u>Rt #1 Hickory</u> (mailing address)	<u>sand</u>	<u>11</u>	<u>108</u>
WELL LOCATION: sec. <u>24</u> T <u>6</u> N R <u>12</u> E	<u>sandy shale</u>	<u>100</u>	<u>110</u>
<u>3</u> miles <u>N</u> of <u>Hickory</u> (distance) (direction) (nearest town)	<u>shale</u>	<u>110</u>	<u>137</u>
WELL PURPOSE: (home, irrigation, municipal, industrial)	<u>Penon shale</u>	<u>127</u>	<u>162</u>
WELL COMPLETION DATA:	<u>sand</u>	<u>162</u>	<u>175</u>
(1) diameter (inches) <u>4"</u>	<u>sandy shale at Rock</u>	<u>175</u>	<u>200</u>
(2) total depth (feet) <u>320'</u>	<u>shale at Rock</u>	<u>200</u>	<u>305</u>
(3) static water level (feet) <u>80'</u> below top of ground.	<u>sand</u>	<u>305</u>	<u>320</u>
(4) casing <u>PVC</u> , <u>130'</u> (material) (depth)			
<u>4</u> (size) if telescope see back.			
(5) screen (length) (depth to top)			
(size) (material)			
(6) pump <u>1/2</u> (HP) <u>8</u> (yield gpm)			
(type power)			
(7) electric log (yes or no)			
(organization running log)			
(8) how well bottom plugged <u>Open</u>			
DRILLERS REMARKS:			


**RECEIVED**

NOV 26 1976

MISS. BD. OF WATER COMMISSIONERS

If well telescopes please sketch and show depths.

GROUND LEVEL

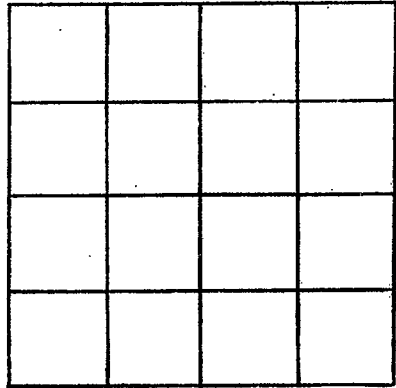

SECTION \_\_\_\_\_

Please indicate well location X.

ADDITIONAL INFORMATION

If more than one screen, show locations of each on sketch.