

Newton  
L 2007  
11-8-76

MISSISSIPPI  
 BOARD OF WATER COMMISSIONERS  
 416 North State Street  
 Jackson, Mississippi 39201

WATER WELL DRILLERS LOG


11-8- 1976 McDonald + Hill Newton  
 date well completed firm name county well located

LANDOWNER:	description of formations encountered	from	to
<u>C. A. Staebek</u>			
<u>Rt #1 Hickory, Box 319</u> (mailing address)	<u>fine sand</u>	<u>16</u>	<u>95</u>
WELL LOCATION: sec. <u>23</u> T. <u>6</u> N. R. <u>12</u> E. <u>3</u> miles <u>N</u> of <u>Hickory</u> (distance) (direction) (nearest town)	<u>sandy shale</u>	<u>95</u>	<u>110</u>
	<u>shale</u>	<u>110</u>	<u>138</u>
	<u>Rock + shale</u>	<u>138</u>	<u>163</u>
WELL PURPOSE: <u>Home</u> (home, irrigation, municipal, industrial)	<u>sand</u>	<u>163</u>	<u>178</u>
WELL COMPLETION DATA:	<u>sandy shale + Rock</u>	<u>178</u>	<u>200</u>
(1) diameter (inches) <u>4"</u>	<u>shale + Rock</u>	<u>200</u>	<u>305</u>
(2) total depth (feet) <u>320'</u>	<u>sand</u>	<u>305</u>	<u>320</u>
(3) static water level (feet) <u>75'</u> below top of ground.			
(4) casing <u>PVC</u> , <u>130'</u> (material) (depth) <u>4"</u> if telescope see back. (size)			
(5) screen _____ (length) (depth to top) (size) (material)			
(6) pump <u>1/2</u> <u>500</u> (HP) (yield' gpm) <u>sub</u> (type power)			
(7) electric log _____ (yes or no) (organization running log)			
(8) how well bottom plugged <u>Open</u>			
DRILLERS REMARKS:			

**RECEIVED**  
 NOV 25 1976  
 MISS. BD. OF WATER COMMISSIONERS

If well telescopes please sketch and show depths.

GROUND LEVEL

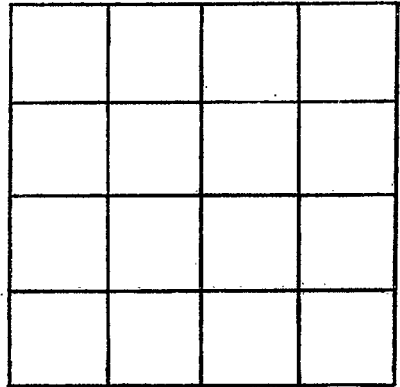

SECTION \_\_\_\_\_

Please indicate well location X.

ADDITIONAL INFORMATION

If more than one screen, show locations of each on sketch.