

NEWTON
L 2008
12/23/76

MISSISSIPPI
BOARD OF WATER COMMISSIONERS
 416 North State Street
 Jackson, Mississippi 39201

WATER WELL DRILLERS LOG

12-23-76 13P **McDonald & Bell** **Newton**
 date well completed firm name county well located

LANDOWNER:

Bennie Walker
Nickory
 (mailing address)

description of formations encountered

from to
 0 30

clay + sand
shale + lignite
 30 53

WELL LOCATION:

sec. **35** T-**6** N R-**12** E
1 1/2 miles **west** of **Nickory**
 (distance) (direction) (nearest town)

sand 53 135

sandy shale 135 155

shale 155 172

WELL PURPOSE:

(home, irrigation, municipal, industrial)

Rock + shells 172 200

WELL COMPLETION DATA:

(1) diameter (inches) **4"**
 (2) total depth (feet) **360'**
 (3) static water level (feet) **60'** below above top of ground.

sand 200 210

(4) casing **PVC, 1 1/2"**
 (material) (depth)
4" If telescope see back.
 (size)

shale + rock 210 348

sand 348 360

(5) screen (length) (depth to top)
 (size) (material)

(6) pump **1/2** **500M.**
 (HP) (yield gpm)
sub
 (type power)

(7) electric log (yes or no)

(organization running log)

(8) how well bottom plugged

RECEIVED


JAN 3 1977

DRILLERS REMARKS:

MISS. BOARD OF WATER COMMISSIONERS

If well telescopes please sketch and show depths.

GROUND LEVEL

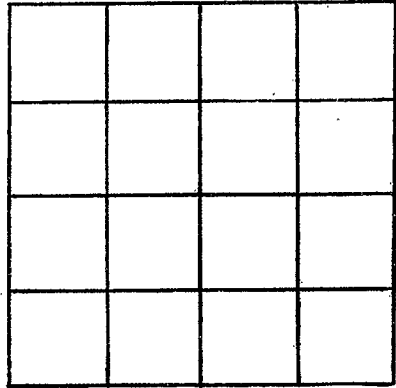

SECTION _____

Please indicate well location X.

ADDITIONAL INFORMATION

If more than one screen, show locations of each on sketch.