

NEWTON  
L 2009  
1-8-77

MISSISSIPPI  
 BOARD OF WATER COMMISSIONERS  
 416 North State Street  
 Jackson, Mississippi 39201

WATER WELL DRILLERS LOG

1-8-77 <sup>131</sup> McDonald & Hill Newton  
 date well completed firm name county well located

LANDOWNER:	description of formations encountered	from	to
<u>JOHNNY BURKS</u>			
<u>Rt #1 Hickory</u> (mailing address)	<u>shale</u>	<u>20</u>	<u>45</u>
WELL LOCATION:	<u>drilled</u>	<u>45</u>	<u>105</u>
sec. <u>25</u> T. <u>6</u> N. R. <u>12</u> E.	<u>sandy shale</u>	<u>105</u>	<u>130</u>
<u>1/2</u> miles <u>N</u> of <u>Hickory</u>	<u>shale</u>	<u>130</u>	<u>157</u>
(distance) (direction) (nearest town)	<u>Rock + shale</u>	<u>157</u>	<u>180</u>
WELL PURPOSE: <u>home</u> (home, irrigation, municipal, industrial)	<u>sand</u>	<u>180</u>	<u>192</u>
WELL COMPLETION DATA:	<u>sandy shales</u>	<u>192</u>	<u>200</u>
(1) diameter (inches) <u>4"</u>	<u>shale + rock</u>	<u>200</u>	<u>310</u>
(2) total depth (feet) <u>360'</u>	<u>shale</u>	<u>310</u>	<u>335</u>
(3) static water level (feet) <u>100'</u> below above top of ground.	<u>sand</u>	<u>335</u>	<u>360</u>
(4) casing <u>PVC</u> <u>1 1/2"</u> (material) (depth)			
<u>4"</u> (size) if telescope see back.			
(5) screen _____ (length) (depth to top)			
(size) _____ (material)			
(6) pump <u>1/2</u> <u>5 gpm</u> (HP) (yield/gpm)			
<u>sub</u> (type power)			
(7) electric log _____ (yes or no)			
(organization running log)			
(8) how well bottom plugged <u>Open</u>			


**RECEIVED**

JAN 20 1977

DRILLERS REMARKS:  
 \_\_\_\_\_  
 \_\_\_\_\_

If well telescopes please sketch and show depths.

GROUND LEVEL

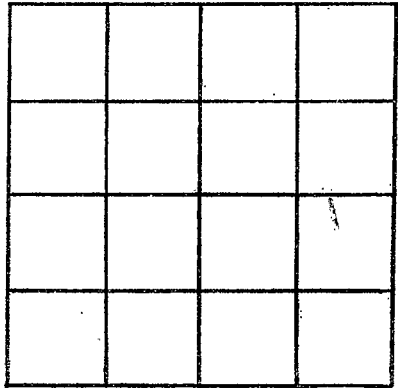

SECTION \_\_\_\_\_

Please indicate well location X.

ADDITIONAL INFORMATION

If more than one screen, show locations of each on sketch.