

NEWTON
L 2010
3-14-77

MISSISSIPPI
 BOARD OF WATER COMMISSIONERS
 416 North State Street
 Jackson, Mississippi 39201

WATER WELL DRILLERS LOG

3-14-77 ¹³⁸ McDonald + Hill Newton
 date well completed firm name county well located


LANDOWNER:	description of formations encountered	from	to
<u>William Lee Larkin</u>			
<u>Rt #2 Decatur</u> (mailing address)	<u>sand</u>	<u>15</u>	<u>90</u>
WELL LOCATION:	<u>shale</u>	<u>90</u>	<u>135</u>
sec. <u>9</u> T. <u>1</u> N. R. <u>12</u> E.	<u>Rock & shale</u>	<u>135</u>	<u>165</u>
<u>4</u> miles <u>S.E.</u> of <u>Decatur</u> (distance) (direction) (nearest town)	<u>sand</u>	<u>165</u>	<u>190</u>
WELL PURPOSE: (home, irrigation, municipal, industrial)			
WELL COMPLETION DATA:			
(1) diameter (inches) <u>4"</u>			
(2) total depth (feet) <u>190'</u>			
(3) static water level (feet) <u>65'</u> below top of ground.			
(4) casing <u>PVC</u> , <u>130'</u> (material) (depth)			
<u>4"</u> (size) If telescope see back.			
(5) screen _____ (length) (depth to top)			
(size) _____ (material)			
(6) pump <u>1/2</u> , <u>59 gpm</u> (HP) (yield gpm)			
<u>E</u> (type power)			
(7) electric log _____ (yes or no)			
(organization running log)			
(8) how well bottom plugged <u>open</u>			
DRILLERS REMARKS:			

RECEIVED
 MAR 24 1977

MISS. BD. OF WATER COMMISSIONERS

If well telescopes please sketch and show depths.

GROUND LEVEL

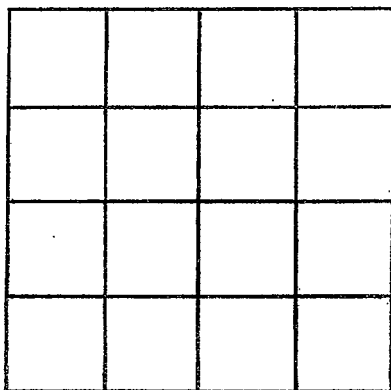

SECTION _____

Please indicate well location X.

ADDITIONAL INFORMATION

If more than one screen, show locations of each on sketch.