

**MISSISSIPPI
BOARD OF WATER COMMISSIONERS**
416 North State Street
Jackson, Mississippi 39201

13P

WATER WELL DRILLERS LOG

NEWTON
L 2011
4-11-77

4-11-77 19 McDonald + Hill Newton
date well completed firm name county well located

LANDOWNER:
J J Roach
Rt # 1 Newton
(mailing address)

WELL LOCATION:
sec. 19 T. 6 (N) R. 12 (E)
3 miles E of Newton
(distance) (direction) (nearest town)

WELL PURPOSE: home
(home, irrigation, municipal, industrial)

WELL COMPLETION DATA:

(1) diameter (inches) 4"

(2) total depth (feet) 320'

(3) static water level (feet) 40' below top of ground.

(4) casing PVC, 250'
(material) (depth)
4" if telescope see back.
(size)

(5) screen — —
(length) (depth to top)
— —
(size) (material)

(6) pump 1/2 6000
(HP) (yield gpm)
E
(type power)

(7) electric log —
(yes or no)
—
(organization running log)

(8) how well bottom plugged open


description of formations encountered	from	to
<u>clay + sand</u>	<u>0</u>	<u>22</u>
<u>shale</u>	<u>22</u>	<u>40</u>
<u>shale + sand</u>	<u>40</u>	<u>60</u>
<u>sand</u>	<u>60</u>	<u>110</u>
<u>shale + lignite</u>	<u>110</u>	<u>120</u>
<u>sand + wt lignite</u>	<u>120</u>	<u>215</u>
<u>sandy shale</u>	<u>215</u>	<u>240</u>
<u>shale</u>	<u>240</u>	<u>275</u>
<u>Rock + shale</u>	<u>275</u>	<u>305</u>
<u>green sand</u>	<u>305</u>	<u>320</u>

DRILLERS REMARKS:

RECEIVED
APR 18 1977

If well telescopes please
sketch and show depths.

GROUND LEVEL

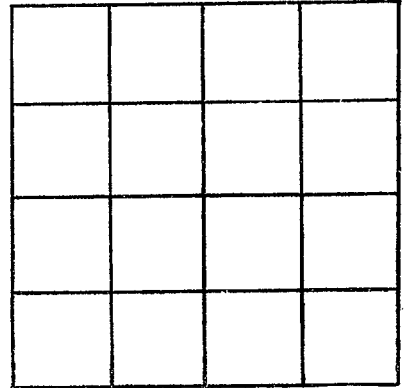

SECTION _____

Please indicate well location X.

ADDITIONAL INFORMATION

If more than one screen,
show locations of each on sketch.