

**NEWTON**  
 L 2013  
 5-17-77

MISSISSIPPI  
 BOARD OF WATER COMMISSIONERS  
 416 North State Street  
 Jackson, Mississippi 39201

WATER WELL DRILLERS LOG

5-17-77<sup>13P</sup> McDonald & Hill Newton  
 date well completed firm name county well located


LANDOWNER:	description of formations encountered	from	to
Ronnie Hurst	clay + sand	0	45
Pt #1 Hickory Bldg 194 (mailing address)	shale	45	55
WELL LOCATION: sec. 15 T. 6N R. 12 E 3 miles NW of Hickory (distance) (direction) (nearest town)	sand	55	78
WELL PURPOSE: <u>home</u> (home, irrigation, municipal, industrial)	sandy shale	78	90
WELL COMPLETION DATA: (1) diameter (inches) <u>4"</u> (2) total depth (feet) <u>300'</u> (3) static water level (feet) <u>65'</u> below top of ground. (4) casing <u>PVC</u> , <u>105'</u> (material) (depth) <u>4"</u> (size) if telescope see back. (5) screen _____ (length) _____ (depth to top) _____ (size) _____ (material) (6) pump <u>1/2</u> <u>59 gpm</u> (HP) (yield/gpm) <u>F</u> (type power) (7) electric log _____ (yes or no) _____ (organization running log) (8) how well bottom plugged <u>open</u>	shale	90	128
	Rock & shells	128	145
	green. sand & sandy shale	145	165
	shale + Rock	165	285
	sand	285	300
DRILLERS REMARKS:			

**RECEIVED**  
 MAY 23 1977

MISS. BD. OF WATER COMM

If well telescopes please  
sketch and show depths.

GROUND LEVEL

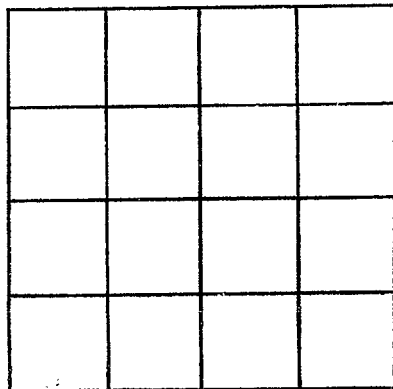

SECTION \_\_\_\_\_

Please indicate well location X.

ADDITIONAL INFORMATION

If more than one screen,  
show locations of each on sketch.