

NEWTON

L 2014

6-7-77

MISSISSIPPI
 BOARD OF WATER COMMISSIONERS
 416 North State Street
 13^P Jackson, Mississippi 39201

WATER WELL DRILLERS LOG

6-7-77¹⁹ date well completed McDonald & Hill firm name Newton county well located

LANDOWNER:

Paul Oglesbee

Hickory

(mailing address)

description of formations encountered

clay + sand

sand

sandy shale

shale

Rock + shells

green sand + sandy shale

Rock + shale

sand

from to

0 30

30 90

90 130

130 148

148 175

175 190

190 330

330 360

WELL LOCATION:

sec. 25 T 6 N R 12 E
 S W
 1 miles N of Hickory
 (distance) (direction) (nearest town)

WELL PURPOSE: home (home, irrigation, municipal, industrial)

WELL COMPLETION DATA:

- (1) diameter (inches) 4"
- (2) total depth (feet) 360'
- (3) static water level (feet) 60' below top of ground.
- (4) casing PVC (material), 140' (depth)
4" (size) if telescope see back.
- (5) screen (length) (depth to top) (size) (material)
- (6) pump 1/2 (HP), 60 gpm (yield/gpm)
E (type power)
- (7) electric log (yes or no)
(organization running log)
- (8) how well bottom plugged Open


RECEIVED
 JUN 13 1977

MISS. Bd. OF WATER COMMISSIONERS

DRILLERS REMARKS:

If well telescopes please sketch and show depths.

GROUND LEVEL

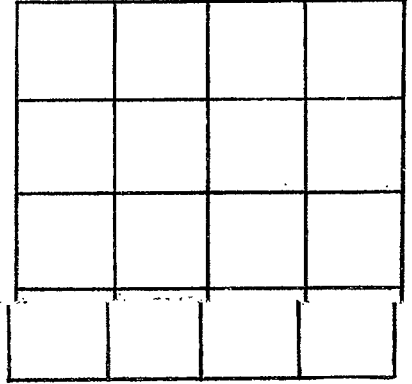

SECTION _____

Please indicate well location X.

ADDITIONAL INFORMATION

If more than one screen,
show locations of each on sketch.