

NEWTON
L 2015
6-19-77

MISSISSIPPI
 BOARD OF WATER COMMISSIONERS
 416 North State Street
 Jackson, Mississippi 39201

WATER WELL DRILLERS LOG

18P

6-19-77 date well completed McDonald & Hill firm name Newton county well located


LANDOWNER:	description of formations encountered	from	to
<u>J B Smith</u>	<u>clay & sand</u>	<u>0</u>	<u>10</u>
(mailing address)	<u>shale</u>	<u>10</u>	<u>55</u>
WELL LOCATION:	<u>sand & shale</u>	<u>55</u>	<u>80</u>
sec. <u>9</u> T. <u>6</u> N. R. <u>13</u> E. S. <u>5</u> W.	<u>sand</u>	<u>80</u>	<u>100</u>
<u>4</u> miles <u>NW</u> of <u>Nickory</u>	<u>sandy shale</u>	<u>100</u>	<u>120</u>
(distance) (direction) (nearest town)	<u>shale</u>	<u>120</u>	<u>155</u>
WELL PURPOSE: <u>home</u>	<u>Rock & shells</u>	<u>135</u>	<u>185</u>
(home, irrigation, municipal, industrial)	<u>green sand sandy shale</u>	<u>185</u>	<u>210</u>
WELL COMPLETION DATA:	<u>Rock & shale at drum</u>	<u>210</u>	<u>240</u>
(1) diameter (inches) <u>4"</u>			
(2) total depth (feet) <u>240</u>			
(3) static water level (feet) <u>87'</u> below above top of ground.			
(4) casing <u>PVC</u> , <u>140'</u> (material) (depth)			
<u>4"</u> (size) If telescope see back.			
(5) screen _____ (length) _____ (depth to top)			
_____ (size) _____ (material)			
(6) pump <u>1/2</u> <u>59 gpm</u> (HP) (yield gpm)			
<u>E</u> (type power)			
(7) electric log _____ (yes or no)			
_____ (organization running log)			
(8) how well bottom plugged <u>Open</u>			
DRILLERS REMARKS:			

RECEIVED
 MAY 29 1977

ATER CO.

If well telescopes please sketch and show depths.

GROUND LEVEL

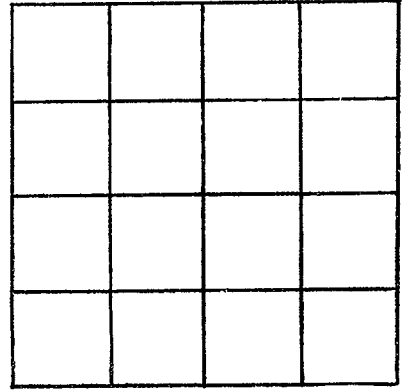

SECTION _____

Please indicate well location X.

ADDITIONAL INFORMATION

If more than one screen,
show locations of each on sketch.