

NEWTON

L 2016

6-6-77

MISSISSIPPI
 BOARD OF WATER COMMISSIONERS
 416 North State Street
 13P Jackson, Mississippi 39201

WATER WELL DRILLERS LOG

6-6-77
date well completed

13P McDonald + Hill
firm name

Newton
county well located

LANDOWNER:

J. W. McMillian

Rt #2 Newton
(mailing address)

description of formations encountered

clay + sand

from

to

0

35

shale

35

50

sand

50

150

sandy shale

150

175

shale

175

225

WELL LOCATION:

sec. 30 T. 6 N R. 2 E
S W
2 1/2 miles E of Newton
(distance) (direction) (nearest town)

WELL PURPOSE: home
(home, irrigation, municipal, industrial)

rock, & shells

225

235

WELL COMPLETION DATA:

- (1) diameter (inches) 4"
- (2) total depth (feet) 250'
- (3) static water level (feet) 35' below top of ground.
- (4) casing PVC, 185' (material) (depth)
4" (size) If telescope see back.
- (5) screen (length) (depth to top)
(size) (material)
- (6) pump 1/2 (HP) 6000 (yield gpm)
E (type power)
- (7) electric log (yes or no)
(organization running log)
- (8) how well bottom plugged open

grease sand

235

250


RECEIVED
JUN 13 1977

MISS. BD. OF WATER COMMISSIONERS

DRILLERS REMARKS:

If well telescopes please
sketch and show depths.

GROUND LEVEL

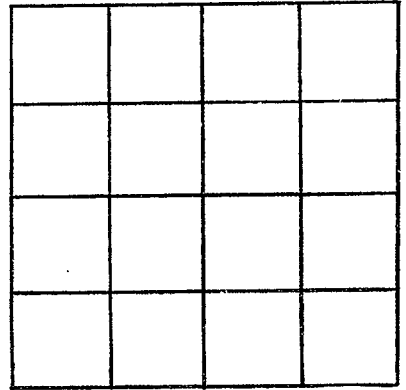

SECTION _____

Please indicate well location X.

ADDITIONAL INFORMATION

If more than one screen,
show locations of each on sketch.